

99 NOV 11 PM 3: 01

LAND CORNER RECORDATION CERTIFICATE  
 Filing Requirement of Act 74, Mich. P.A. 1970

*Charles M. Jostoy*

For corners in

| Charlevoix<br>(County)                | Located In: | Corner Code # |
|---------------------------------------|-------------|---------------|
| 1. Public Land Survey                 | T 33N R 8W  | I-12          |
|                                       | T R         |               |
|                                       | T R         |               |
|                                       | T R         |               |
| 2. Property Controlling<br>in Section | S T R       |               |
|                                       | S T R       |               |
| 3. Miscellaneous<br>Property in Sec.  | S T R       |               |
|                                       | S T R       |               |

REGISTER OF DEEDS

RE...

FEB 2000

SECTION

Register of Deeds Stamp & File Number

4. Lot No. \_\_\_\_\_, Recorded Plat \_\_\_\_\_  
 5. Private Claims \_\_\_\_\_

Wayne E. Boss

OCTOBER 99

I, \_\_\_\_\_, in a field survey on \_\_\_\_\_, 19\_\_\_\_ do hereby state that under requirements of P.A. 74, Michigan P.A. of 1970, the corner points mentioned in lines 1 and 2 above were in conformance with regulations and rules therefore as required in the current manual of survey instructions of the United States Department of the Interior, Bureau of Land Management or by a decree of a Court of Law and /or that the corner points mentioned in lines 3, 4 and 5 above were in conformance with the rules of the Michigan Board of Land Surveyors or by a Decree of a Court of Law; established, re-established, monumented, recovered, found as expressed below:

NOTE: Not more than 2 corners, all in the same town and range, may be recorded on this certificate.

|    | A  | B | C  | D | E  | F | G  | H | I  | J | K  | L | M |
|----|----|---|----|---|----|---|----|---|----|---|----|---|---|
| 1  |    |   |    |   |    |   |    |   |    |   |    |   |   |
| 2  | 6  |   | 5  |   | 4  |   | 3  |   | 2  |   | 1  |   |   |
| 3  |    |   |    |   |    |   |    |   |    |   |    |   |   |
| 4  | 7  |   | 8  |   | 9  |   | 10 |   | 11 |   | 12 |   |   |
| 5  |    |   |    |   |    |   |    |   |    |   |    |   |   |
| 6  | 10 |   | 17 |   | 16 |   | 15 |   | 14 |   | 13 |   |   |
| 7  |    |   |    |   |    |   |    |   |    |   |    |   |   |
| 8  | 19 |   | 20 |   | 21 |   | 22 |   | 23 |   | 24 |   |   |
| 9  |    |   |    |   |    |   |    |   |    |   |    |   |   |
| 10 | 30 |   | 29 |   | 28 |   | 27 |   | 26 |   | 25 |   |   |
| 11 |    |   |    |   |    |   |    |   |    |   |    |   |   |
| 12 | 31 |   | 32 |   | 33 |   | 34 |   | 35 |   | 36 |   |   |
| 13 |    |   |    |   |    |   |    |   |    |   |    |   |   |

A. Description of original monument and accessories and/or subsequent restoration:

|  |   |
|--|---|
| <p>I-12 OCTOBER 1841<br/>                 CHARLES W. CATHCART, DEPUTY SURVEYOR<br/>                 PLACED 1/4 POST<br/>                 SUGAR 30 INCH N30°W 2.5 LINKS (1.65')<br/>                 SUGAR 10 INCH N75°E 17 LINKS (11.22')<br/>                 JULY 1978, NB DEYOUNG PLACED 1/2" IRON<br/>                 IN LINE WITH NORTH LINE OF GRAVEL ROAD<br/>                 DECEMBER 1982, LR FEINDT<br/>                 FD. 1/2" IRON, WITNESSES BY WE BOSS</p> | <p>1922 R.F SLOAN, ENGINEER<br/>                 FOUND GOVERNMENT CORNER AND<br/>                 PLACED 1/2" IRON PIPE, NO WITNESSES NOTED<br/>                 NOV. 1979, WE BOSS FD. 1/2" IRON<br/>                 3" MAPLE N40°W 83.05', 14" MAPLE N65°E 70.9'<br/>                 12" MAPLE S50°E 74.4'<br/>                 APRIL 1998 &amp; JUNE 1999, JE FERGUSON ASSOCIATES<br/>                 FD. 1/2" RE-ROD, 4" ASH S62°E 52.81', 5" ASH N22°W 77.02'<br/>                 4" ASH N65°E 30.32' PWR POLE SOUTH 131.80'</p> |
|--|---|


B. Description of corner evidence found and/or method applied in restoring or reestablishing corner:

I-12 OCTOBER 1999, FOUND 1/2" IRON IN EAST SHOULDER ON NORTH-SOUTH ROAD AS RECORDED IN Liber 274, Page 470. CHARLEVOIX COUNTY RECORDS, CORNER DETERMINED TO BE ERRONEOUS BASED ON 1922 RF SLOAN SUBDIVISION OF ENTIRE SECTION. NO EVIDENCE OF GOVERNMENT WITNESSES REMAINING REESTABLISHED LOCATION PER RF SLOAN MAP.  
 GLO I-13 TO I-12 40 CHAINS (2640FT.), RF SLOAN 2751FT. MEASURES 2747.48FT.  
 I-12 TO J-12 RF SLOAN 2393FT. MEASURES 2390FT.  
 GLO I-12 TO I-11 40 CHAINS (2640FT.) RF SLOAN 2717FT. MEASURES 2713.53 FT.

C. Description of monument for corner and accessories established to perpetuate locating the position of the corner:

I-12 PLACED CHARLEVOIX COUNTY STEEL MARKER AND MONUMENT BOX  
 6" ELM S62°W 45.51' SET NAIL AND TAG  
 5" ELM N41°W 70.13' SET NAIL AND TAG  
 ELECTRIC POLE S37°E 67.92' SET NAIL AND TAG  
 1/2" NBD IRON N18°14'E 74.89', PREVIOUSLY USED AS 1/4 CORNER IN Li. 274, P. 470  
 CENTER LINE OF NORTH-SOUTH COUNTY COUNTY ROAD EAST 3.1'

Charlevoix Co. Surveyor  
**APPROVED**  
 Signature: *Wayne E. Boss*  
 Date: *Oct 21, 1999*

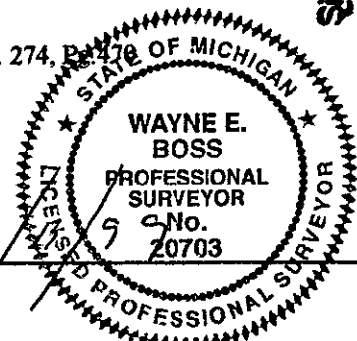

Signed by *Wayne E. Boss*  
 Surveyor's Michigan License No. 20703

Date 11/11/99