


MEANDER CORNER DESIGNATION FOR REMONUMENTATION PROGRAM

Town 33 North Range 8 West.

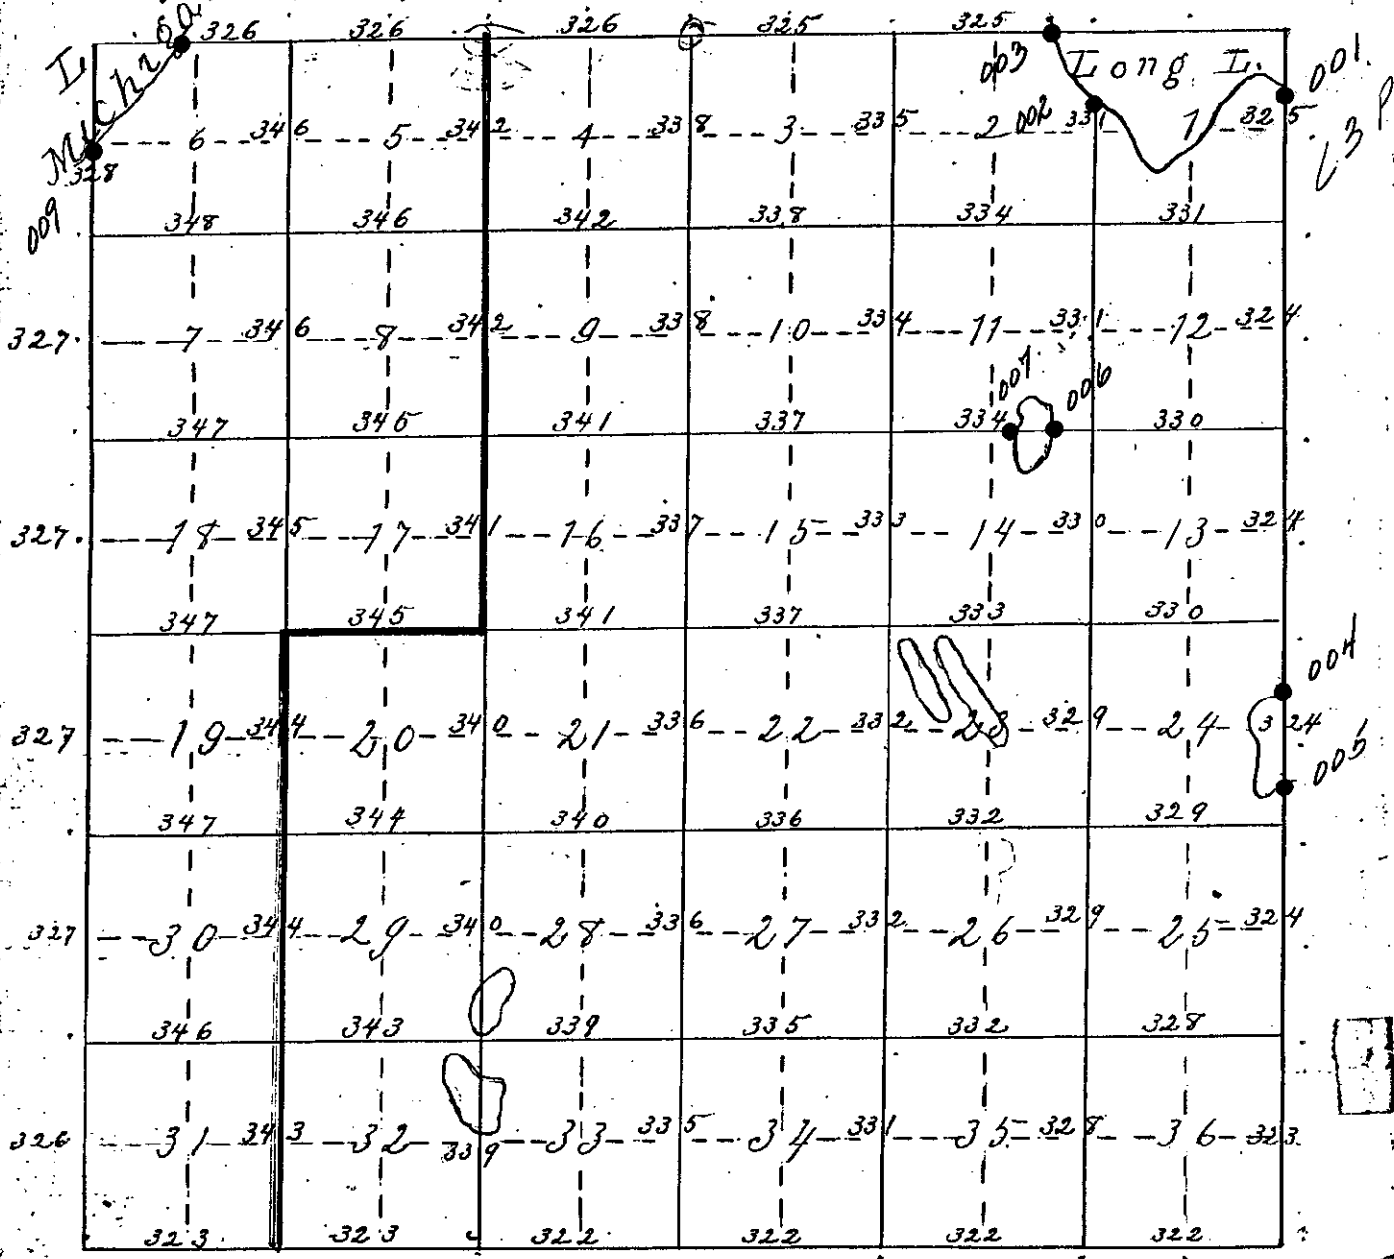

NORWOOD TWP | MARION TWP
 Meander Lines on Pages 348 to 351 inclusive

SURVEY & REMONUMENTATION
 FEB 04 1999
 SECTION

MARION TOWNSHIP
 Charlevoix County.