

# LAND CORNER RECORDATION CERTIFICATE

## FILING REQUIREMENT OF ACT 74, MICH. P.A.1970

| FOR CORNERS OF --:                         | LOCATED IN --:                               | CORNER CODE NUMBER       |
|--|--|--------------------------|
| 1. PUBLIC LAND SURVEY _____                | T. <u>33</u> N. <u>9</u> W.                  | I-10<br>J-11; K-10, K-11 |
| 2. PROPERTY CONTROLLING IN SECTION _____   | T. _____ N. _____ S. _____ R. _____ W. _____ | _____                    |
| 3. MISCELLANEOUS PROPERTY IN SECTION _____ | T. _____ N. _____ S. _____ R. _____ W. _____ | _____                    |
| 4. LOT NO. _____, RECORDED PLAT _____      |  |                          |
| 5. PRIVATE CLAIMS _____                    |  |                          |

REGISTER OF DEEDS STAMP AND FILING NUMBER

I, CARL F. ROSER, do hereby certify that under requirements of P.A. 74, Michigan P.A. of 1970, the corner points mentioned in lines 1 and 2 above were, in a field survey on FEBRUARY 26, 1986, established, re-established, monumented, re-monumented, recovered or restored as expressed below and in conformance with regulations and rules therefore as required in the current manual of survey instructions of the United States Department of the Interior, Bureau of Land Management or by a decree of a court of law. Furthermore, that the corner points mentioned in lines 3, 4 and 5 above were, in a field survey on \_\_\_\_\_, 19\_\_\_\_, found, recovered, restored, established or re-established as expressed below and in conformance with the rules of the Michigan State Board of Registration for Land Surveyors or, by a Decree of a Court of law:

**B. (CONTINUED)**

**C. (CONTINUED)**

A. Description of original monument and accessories and/or subsequent restoration:

- |  |      |   |
|--|------|---|
| <p>I-10 FD &amp; ACCEPTED 1" X 24" IRON FOR W 1/4 COR OF SEC. 26. PREVIOUSLY USED &amp; WITNESSED BY RLS NICK DEYOUNG IN SUR DATED NOV 1978. A N-S TRAIL RD IN CURVE IS 34'± EAST. WATERS EDGE OF LK MICH IS 300'± WEST.</p> | I-10 | <p>FD 1" X 24" SOLID IRON; REPLACED W/DNR MON &amp; DROVE STEEL FN POST.<br/>                 **11" CEDAR N32°E 11.0'<br/>                 **12" MAPLE S40°E 2.5'<br/>                 **12" MAPLE N60°W 12.2'<br/>                 12" CEDAR S20°W 33.8'</p> |
|--|------|---|

\*\*WITS USED BY PREVIOUS SURVEYOR.

B. Description of corner evidence found and/or method applied in restoring or re-establishing corner:

- J-11 FD 1/2" ROD W/RLS CAP (PROBABLY BY NICK DEYOUNG) DRIVEN IN ROOTS OF 30" TWIN MAPLE (NW SIDE), FN'S E-W-S.
- K-10 FD 3/4" PIPE FLUSH W/SURFACE OF E-W BIT SURFACE RD; IN APPROX. LINE W/FENCE TO S & 1.4' N OF CTR OF RD. COR FITS E.A.ROBINSON 1909 DISTANCE EAST 1/2 MILE REAL CLOSE & E.K.ROBINSON'S 1887 DISTANCES 1/2 MILE N & S REASONABLY WELL. SEE NORWOOD BK. PGS 19 & 23; NOTES IN JURY ROOM AT GOVT. BLDG.
- K-11 RESTORED SE COR OF SEC 26 AT N EDGE OF OLD COR FN POST (RECENTLY REPLACED W/NEW CED POST), OLD FN'S E-W-S. NEW ELEC. FN RUNS E & S. COR FITS E.K.ROBINSON 1887 N.B.T. ALSO USED & NOTED BY E.A.ROBINSON IN 1909. BEECH 18 (NOW A 30" DEAD, TALL, HOLLOW STUB), N26 1/2°W 44.2' SEE NORWOOD BK, PG 19; NOTES IN JURY ROOM AT GO BLDG.

C. Description of monument for corner and accessories established to perpetuate locating the position of the corner:

| J-11   | K-10                            | K-11                            |
|--|---------------------------------|---------------------------------|
| FD 1/2" ROD W/RLS CAP DRIVEN IN ROOTS OF 30" TWIN MAPLE. | FD 3/4" PIPE IN B.TOP RD        | DROVE 5/8" X 34" REROD AT N     |
| 30" TW MAPLE S45°E 1.23                                  | 10" ELM S48°E 86.30             | EDGE OF COR FN POST PER         |
| 28" MAPLE N30°W 10.24                                    | COR FN POST (S-E-W) S02°W 66.15 | E.K.ROBINSON 1887 WIT.          |
| 12" DEAD TW ELM N70°W 13.98                              | 2" CEDAR S36°W 66.35            | 19" MAPLE N40°W 9.75            |
| 8" MAPLE N30°E 45.20                                     | 5" LOCUST N54°W 53.75           | 24" MAPLE S80°E 17.18           |
|  |                                 | 7" BEECH S30°W 3.61             |
|  |                                 | **30" DEAD BEECH N26 1/2°W 44.2 |

\*\*E.K.ROBINSON 1887 WIT.

SIGNED BY Carl F. Roser 03-26-86 DATE \_\_\_\_\_

SURVEYOR'S MICHIGAN REGISTRATION NO. 12028


FOR STATE AND UNITED STATES AGENCIES:

SIGNED BY \_\_\_\_\_ DATE \_\_\_\_\_

CHIEF OF SURVEY PARTY

APPROVED AND SIGNED BY \_\_\_\_\_ DATE \_\_\_\_\_

MICHIGAN REGISTERED LAND SURVEYOR

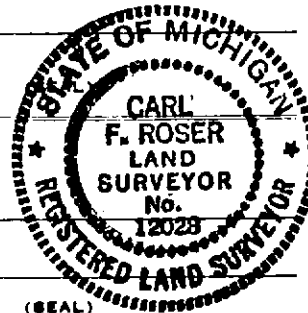

CHARLEVOIX COUNTY  
NORWOOD TOWNSHIP

SURVEYOR'S MICHIGAN REGISTRATION NO. \_\_\_\_\_