

FEB 04 1999

STATE OF MICHIGAN
 COUNTY OF CHARLEVOIX
 REGISTER OF DEEDS

98 DEC 28 PM 12:23

SECTION

LAND CORNER RECORDATION CERTIFICATE
 Filing Requirement of Act 74, Mich. P.A. 1970

Charles W. Nettleton
 REGISTER OF DEEDS

For corners in

Charlevoix

Located In:

Corner Code #

(County)

1. Public Land Survey	T <u>34</u> N R <u>8</u> W	<u>K-7</u>
	T <u> </u> R <u> </u>	<u> </u>
	T <u> </u> R <u> </u>	<u> </u>
	T <u> </u> R <u> </u>	<u> </u>
2. Property Controlling in Section	S <u> </u> T <u> </u> R <u> </u>	<u> </u>
	S <u> </u> T <u> </u> R <u> </u>	<u> </u>
3. Miscellaneous Property in Sec.	S <u> </u> T <u> </u> R <u> </u>	<u> </u>
	S <u> </u> T <u> </u> R <u> </u>	<u> </u>

Register of Deeds Stamp & File Number

4. Lot No. _____, Recorded Plat _____
 5. Private Claims _____

Wayne E. Boss

NOV 98

I, Wayne E. Boss, in a field survey on NOV, 1998 do hereby state that under requirements of P.A. 74, Michigan P.A. of 1970, the corner points mentioned in lines 1 and 2 above were in conformance with regulations and rules therefore as required in the current manual of survey instructions of the United States Department of the Interior, Bureau of Land Management or by a decree of a Court of Law and for that the corner points mentioned in lines 3, 4 and 5 above were in conformance with the rules of the Michigan Board of Land Surveyors or by a Decree of a Court of Law; established, re-established, monumented, recovered, found as expressed below:

1	A	B	C	D	E	F	G	H	I	J	K	L	M
2		6		5		4		3		2		1	
3													
4		7		8		9		10		11		12	
5													
6		10		17		16		15		14		13	
7													
8		19		20		21		22		23		24	
9													
10		30		29		28		27		26		25	
11													
12		31		32		33		34		35		36	
13													

NOTE: Not more than 2 corners, all in the same town and range, may be recorded on this certificate.

A. Description of original monument and accessories and/or subsequent restoration:

K-7 OCTOBER 22, 1841 Ch. W. CATHCART DEPUTY SURVEYOR, PLACED CORNER BEECH 4 INCH N65*E 8 LINKS BEECH 6 INCH N87*W 16 LINKS SEP. 16, 1879, D.C. NETTLETON FD. SLAWSON STONE AND GLO WITNESSES BEECH 4" N65*E 8 LINKS, BEECH 6" N87*W 16 LINKS BEFORE 1889 E.K. ROBINSON FD. STONE BY SLAWSON BEECH 4" N65*E 8 LINKS, BEECH 6" N87*W 16 LINKS	SEP. 26, 1898 D.C. NETTLETON FD. IRON PIN 1"x24" MAY 3, 1902 D.C. NETTLETON FD. IRON PIN TEL. POLE S15*E 90' MAPLE 3" N83*W 112 1/2 FT. JUNE 6, 1924 E.A. ROBINSON FOUND CORNER, NO WITNESSES NOTED SEE SHEET TWO
--	--

B. Description of corner evidence found and/or method applied in restoring or reestablishing corner:

K-7 NOVEMBER 17, 1998 FOUND 1/2" IRON INSIDE OF 1" PIPE IN CENTER LINE OF ROAD INTERSECTION
 30" MAPLE S65*W 48.80' NAIL & CAP 3920 (MARY C. FEINDT)
 12" MAPLE N30*E 51.50' NAIL & CAP 3920
 TELEPHONE POLE N20*W 48.48' NAIL & CAP 3920
 POWER POLE S15*W 53.73' PK NAIL TAG 31601 (ARTHUR RANGER)
 CONCRETE MONUMENT N45*E 45.47'
 L-7 TO K-7 G.L.O. 40 CHAINS (2640') D.C. NETTLETON MEASURED 40.66 CHAINS (2683.56') MEASURES 2683.06'
 K-7 TO K-8 RECORDED AS 2653.39' AND 2653.51', NETTLETON MEAS. 40.2 CHNS. (2653.2') MEASURES 2653.50'


C. Description of monument for corner and accessories established to perpetuate locating the position of the corner:

K-7 PLACED HARRISON MONUMENT AND CAST IRON MONUMENT BOX
 30" MAPLE S65*W 49.38' NAIL & CAP 3920
 12' MAPLE N30*E 52.22' NAIL & CAP 3920
 TELEPHONE POLE N20*W 48.48' NAIL & CAP 3920
 CONCRETE MONUMENT N45*E 45.54'
 POWER POLE S28*W 53.80' PK NAIL & TAG 31601 IN NE FACE
 AND IS ACCEPTED AS A CAREFUL & FAITHFUL REESTABLISHMENT OF THE POSITION OF THE ORIGINAL CORNER

Charlevoix Co. Surveyor
APPROVED
 Signature Mary C. Feindt
 Date: Dec 24 1998

Signed by Wayne E. Boss
 Surveyor's Michigan License No. 20703

Date _____

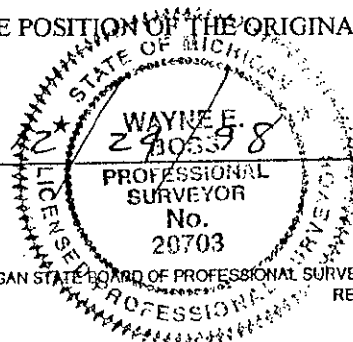

K-7 WITNESSES CONTINUED

DECEMBER 7, 1973 PETER E. CHENARD, USED SECTION CORNER NO WITNESSES NOTED

APRIL 22, 1981 SHERMAN A. CHAMBERLAIN FOUND 1/2" ROD
30" MAPLE S65*W 48.80'
32" MAPLE N40*W 50.20'
12" MAPLE N30*E 51.50'

AUGUST 13, 1986 AND JULY, 8, 1988
GEORGE J. AVENDT,
FOUND 1/2" ROD
30" MAPLE S65*W 48.80'
32" MAPLE N40*W 50.10'
12" MAPLE N30*E 51.50'

OCTOBER 17, 1991, MARY C. FEINDT
FOUND 1/2" ROD
30" MAPLE S65*W 48.80'
32" MAPLE N40*W 50.20'
12" MAPLE N30*E 51.5'


DECEMBER 4, 1991, ARTHUR R. RANGER
FOUND 1/2" ROD
CONC. MONUMENT N45*E 45.47'
1/2" ROD N45*W 48.59'
18" MAPLE S45*W 48.59'
POWER POLE S 15*W 53.73'

AUGUST 18, 1993, JAMES E. EVANS
FOUND 1/2" ROD
30" MAPLE S65*W 48.80'
32" MAPLE N40*W 50.20'
12" MAPLE N30*E 51.50'

SURVEY &
REMONUMENTATION

FEB 04 1999

SECTION

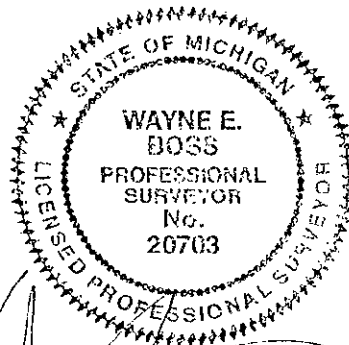

A handwritten signature in black ink, appearing to read "Wayne E. Boss", written over the bottom portion of the professional seal.