

FEB 04 1999

SECTION

LAND CORNER RECORDATION CERTIFICATE
Filing Requirement of Act 74, Mich. P.A. 1970

STATE OF MICHIGAN
COUNTY OF CHARLEVOIX
REGISTER OF DEEDS

98 DEC 28 PM 12: 25

Charles E. Chamberlain
REGISTER OF DEEDS

For corners in
Charlevoix

Located In:	Corner Code #
T 34N R 8W	K-8
T R	
T R	
T R	
T R	
S T R	
S T R	
S T R	
S T R	

1. Public Land Survey

2. Property Controlling
in Section

3. Miscellaneous
Property in Sec.

4. Lot No. _____, Recorded Plat _____
5. Private Claims _____

Wayne E. Boss NOV. 98

I, _____, in a field survey on _____, 19 ____ do hereby state that under requirements of P.A. 74, Michigan P.A. of 1970, the corner points mentioned in lines 1 and 2 above were in conformance with regulations and rules therefore as required in the current manual of survey instructions of the United States Department of the Interior, Bureau of Land Management or by a decree of a Court of Law and for that the corner points mentioned in lines 3, 4 and 5 above were in conformance with the rules of the Michigan Board of Land Surveyors or by a Decree of a Court of Law; established, re-established, monumented, recovered, found as expressed below:

NOTE: Not more than 2 corners, all in the same town and range, may be recorded on this certificate.

Register of Deeds Stamp & File Number

	A	B	C	D	E	F	G	H	I	J	K	L	M
1													
2	6		5		4		3		2		1		
3													
4	7		8		9		10		11		12		
5													
6	18		17		16		15		14		13		
7													
8	19		20		21		22		23		24		
9													
10	30		29		28		27		26		25		
11													
12	31		32		33		34		35		36		
13													

A. Description of original monument and accessories and/or subsequent restoration:

K-8	OCT. 1841 Ch.W.CATHCART DEPUTY SURVEYOR PLACED QUARTER POST BEECH 20 INCH N35*W 16 LINKS BEECH 6 INCH N55*W 33 LINKS PRIOR TO 1879, SLAWSON PLACED STONE NO WITNESSES	SEP. 1879 D.C. NETTLETON FD. SLAWSONS STONE SET CORNER 25 LINKS FROM SLAWSON STONE OAK 18" N22*W 134 1/2 LINKS WILD CHERRY 6" S85 1/2*W 185 LINKS JUNE 30, 1912, E.A.ROBINSON SET WELL POINT 2653.1' SOUTH OF SECTION CORNER SUGAR 4" N48 1/2*E 31.4'. RED SHADE 4" S33 3/4*E 77.6'	JUNE 1981, S.A.CHAMBERLAIN FD. 1" ROD POWER POLE N35*E 59.55' 12" MAPLE N35*W 87.70' 20" OAK S40*E 76.95' 1 1/4" ROD S50*W 2.85'
-----	--	---	---

B. Description of corner evidence found and/or method applied in restoring or reestablishing corner:

K-8 NOVEMBER 17, 1998
FOUND 1" PIPE & WHITE CROCKERY WITH LARGE NAIL IN TOP ALL INSIDE 4" WELL PIPE 12" BELOW SURFACE
POWER POLE N35*E 59.55' FD. NAIL & CAP 21566 (L.R.FEINDT)
20" OAK S40*E 76.90' FD. NAIL & TAG 16034, NAIL & TAG 14200
1 1/4" ROD S50*W 2.85'
PUBLIC WARNING POLE N32*W 59.36' FD. NAIL & CAP 21566
K-8 TO K-7 GLO 40 CHAINS (2640') D.C.NETTLETON 40.2 CHAINS (2653.2') MEASURES 2653.50'
K-8 TO K-9 GLO 23.90 CHAINS (1577.4') D.C.NETTLETON 24.05' CHAINS (1587.3') MEASURES 1159.45'


Charlevoix Co. Surveyor
APPROVED
Signature *Mary C. Bennett*
Date: Dec 24 1998

C. Description of monument for corner and accessories established to perpetuate locating the position of the corner:

K-8 1" PIPE AND NAIL IN PLACE WITH 4" WELL PIPE AND PLACED CAST IRON MONUMENT BOX
POWER POLE N35*E 59.87' NAIL & CAP 21566
34" OAK S33*E 77.81' TO NAIL & CAP 16034 (G.J.AVENDT), AND 77.62' TO NAIL & TAG 14200
1 1/4" ROD S50*W 2.85'
PUBLIC WARNING POLE N32*W 59.36' TO NAIL & TAG 21566

AND IS ACCEPTED AS A CAREFUL & FAITHFUL REESTABLISHMENT OF THE POSITION OF THE ORIGINAL CORNER

Signed by *Wayne E. Boss*
Surveyor's Michigan License No. 20703

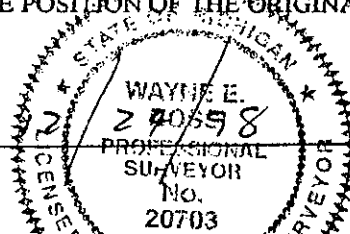Date _____


K-8 WITNESSES CONTINUED

ESTIMATED 1984, J.E.FERGUSON
FOUND IRON NO WITNESSES

AUGUST 7, 1986, & JULY 8, 1988 G.J.AVENDT
FOUND 1" ROD
POWER POLE N35°E 59.55'
12" MAPLE N35°W 87.70'
20" OAK S40°E 76.90'
1 1/4" ROD S50°W 2.85'

SURVEY &
REMONUMENTATION


FEB 04 1999

SECTION

OCTOBER 13, 1991, MARY C. FEINDT
FOUND 1" ROD
POWER POLE N35°E 59.55'
12" MAPLE N35°W 87.70'
20" OAK S40°W 76.90'
1 1/4" ROD S50°17'49"W 2.85'

SEP. 1993, J.E.EVANS
FOUND 1" ROD
POWER POLE N35°E 59.95'
12" MAPLE N35°W 87.70'
20" OAK S40°W 76.90'
1 1/4" ROD S50°17'49"W 2.85'

SEPTEBER 22, 1997, J.E.EVANS
FOUND 1" ROD SET BY E.A.ROBINSON
POWER POLE N35°E 59.85' SET NAIL & CAP 16034/21566
POWER POLE N28°W 59.31' SET NAIL & CAP 16034/21566
28" OAK S40°W 77.80' SET NAIL & CAP 16034/21566
FOUND 1 1/4" ROD S50°W 2.85'

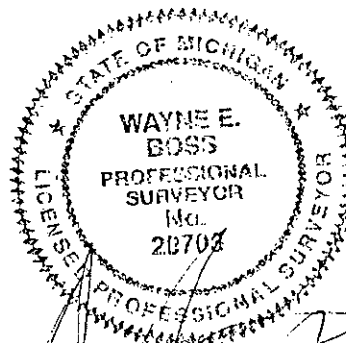

A handwritten signature in black ink, appearing to read "Wayne E. Boss", written over the bottom portion of the professional seal.