LAND CORNER RECORDATION CERTIFICATE Filing Requirement of Act 74, Mich. P.A. 1970

_		
FAI	corners	ın
101	COLLICIS	717

	Cheboygan	Located In:	Corner Code ##
1.	Public Land Survey	T 33N R 1E T 33N R 1E T 33N R 1E T 33N R 1E	G-6 I-6 H-7 H-5
2.	Property Controlling in Section	S T R S T R	
3.	Miscellaneous Property in Sec.	S . T R S T R	


Register of Deeds Stamp & File Number


4. Lot No. _____, Recorded Plat ___

5. Private Claims Feb. 25 - G-6 Feb. 26 - I-6 Feb. 27 - H-7

Carl R. Johnson , in a field survey on May 6 — H-5 , 19 86 , do hereby certify that under requirements of P.A. 74, Michigan P.A. of 1970, the corner points mentioned in tines 1 and 2 above were in conformance with regulations and rules therefore as required in the current manual of survey instructions of the United States Department of the Interior, Bureau of Land Management or by a decree of a Court of Law and/or that the corner points mentioned in lines 3, 4 and 5 above were in conformance with the rules of the Michigan Board of Land Surveyors or by a Decree of a Court of Law; established, re-established, monumented, re-monumented, recovered, found as expressed below:

NOTE: Not more than 4 corners, all in the same town and range, may be recorded on this certificate.

 

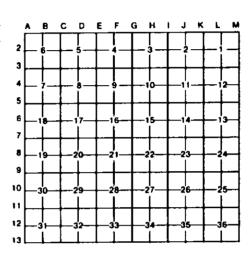

- B. Description of corner evidence found and/or method applied in restoring or reestablishing corner:
 - G-6 Set midway and on line between found recorded section corners.
 - I-6 Set midway and on line between found recorded section corners.
 - H-7 Set midway and on line between found recorded section corners.
 - H-5 Found 14" pipe in concrete. Set by Marcus Schaaf, RLS. Set corner to perpetuate this location.

_ Date ___

C. Description of monument for corner and accessories established to perpetuate locating the position of the corner:

G-6				<u>1-6</u>	
18" White Pine	N32°E	21.5'	Set DNR Mor		-
9" Red Pine	N60 ⁰ W	10.3'	5" Maple	ธ56 [°] ัพ	28.8
7" Red Pine	S30°E	21.5'	7" Maple	S86°E	18.9

(Set DNR Mon. & Cedar Post.)

(bee 2 a dead reserv,				
н-7	<u>H-5</u>			
Set DNR Mon. & Cedar Post	Found 14" pipe set DNR Mon.			
16" Red Pine N42°E 128.0'	6" White Pine North 17.2'			
6" Red Pine N63 ⁰ W 36.9'	3" White Pine S20°W 20.4'			
	6" White Spruce \$36°E 18.3"			

Signed by Call Surveyor's Michigan License No. 30083

CARL R.
JOHNSON A
LAND
No.
30083
LAND SURVEYOR
NO.
CAND SURVEYOR
N