LAND CORNER RECORDATION CERTIFICATE

Filing Requirement of Act 74, Mich. P.A. 1970

For corners in CHEBOYGAN (County)

	Located In:	Corner Code ##
1. Public Land Survey	T 33N R 1E	K-13,
	T ____ R ____	L-13
	T ____ R ____	
	T ____ R ____	
2. Property Controlling	S 36 T ____ R ____	16
in Section	S ____ T ____ R ____	
3. Miscellaneous	S ____ T ____ R ____	
Property in Sec.	S ____ T ____ R ____	

Register of Deeds Stamp & File Number

4. Lot No. _____ , Recorded Plat _____
5. Private Claims _____

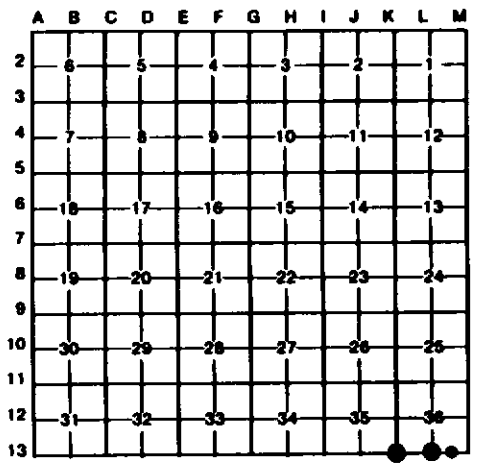

I, CARL T. KIISKILA , in a field survey on DECEMBER 12 , 19 95 , do hereby certify that under requirements of P.A. 74, Michigan P.A. of 1970, the corner points mentioned in lines 1 and 2 above were in conformance with regulations and rules therefore as required in the current manual of survey instructions of the United States Department of the Interior, Bureau of Land Management or by a decree of a Court of Law and/or that the corner points mentioned in lines 3, 4 and 5 above were in conformance with the rules of the Michigan Board of Land Surveyors or by a Decree of a Court of Law; established, re-established, monumented, re-monumented, recovered, found as expressed below:

NOTE: Not more than 4 corners, all in the same town and range, may be recorded on this certificate.

A. Description of original monument and accessories and/or subsequent restoration:

K-13

(NO EVIDENCE OF G.L.O. CORNER, B.T'S, LINE TREES & TOPOGRAPHY, AS CALLED OUT IN THE G.L.O. LINE NOTES; UNLESS NOTED IN ITEM "B" BELOW.)

L-13

16

B. Description of corner evidence found and/or method applied in restoring or reestablishing corner:

K-13

FD AND ACCEPTED A 1 1/2" PIPE W/CONC AS SET BY MICH DEPT OF CONSERVATION SURVEYOR MARCUS SCHAAF FOR THE SW CORNER OF SECTION 36. THIS CORNER WAS ALSO ACCEPTED BY RLS DELMER PORTER AND SHELL OIL CO. (PERLA STOUT & ASSOC.) DURING SUBSEQUENT SURVEYS. PIPE FALLS ON E-W SMOOTH WIRE FENCE.

L-13

FD AND ACCEPTED A 1 1/2" PIPE W/CONC AS SET BY MICH DEPT OF CONSERVATION SURVEYOR MARCUS SCHAAF FROM U.S. PINE B.T. STUMPS. CORNER IS ON E-W SMOOTH WIRE FENCE. CENTER E-W TRAIL IS 6' SOUTH.

16

ESTABLISHED THE SE CORNER OF THE SW 1/4 OF THE SE 1/4 SEC. 36 BY STANDARD BLM PROCEDURE FOR SUBDIVISION OF A SECTION. E-W SMOOTH WIRE FENCE IS 1' SOUTH. CTR E-W TRAIL IS 6' SOUTH.

C. Description of monument for corner and accessories established to perpetuate locating the position of the corner:

K-13

FD 1 1/2" IRON PIPE, ADDED PS CAP & SET CARSONITE POST.

* 8" J PINE	S20°E	19.76'
*10" J PINE	N49°W	10.02'
*11" J PINE	N87°E	17.24'
8" J PINE	S34°W	16.23'

*OLD WIT BY PERLA STOUT & ASSOC

L-13

SET 5/8" X 36" REBAR IN FD 1 1/2" PIPE W/CONC.

6" OAK	N25°W	22.74'
5" MAPLE	N53°E	21.86'
16" OAK	S63°E	72.93'
3" OAK	S40°W	41.94'

16

SET 5/8" X 36" REBAR.

4" MAPLE	S33°E	24.05'
4" IRONWOOD	S66°W	33.60'
14" OAK	N31°W	19.15'
12" OAK	S85°E	52.38'

STATE OF MICHIGAN
CARL KIISKILA
LAND SURVEYOR
No. 33981
LICENSED LAND SURVEYOR

Signed by Carl T Kiiskila ~~33981~~ Date 4-3-96

Surveyor's Michigan License No. _____

FORM APPROVED BY MICHIGAN STATE BOARD OF LAND SURVEYORS, JAN. 26, 1971
REVISED MAY 14, 1975
REVISED JAN., 1983