

MICHIGAN  
DEPARTMENT OF CONSERVATION  
FORESTRY DIVISION

# LAND CORNER RECORD

T. 33 N.R. 1 W  
T. 34 NR 1 W


Cheboygan COUNTY

DESCRIPTION OF CORNER Section corner common to Sections 32, 33, 4, 5

CORNER MONUMENT Set 1" pipe with 4" Aluminum cap

DATE MONUMENT PLACED AND WITNESSED 10/15/62

WITNESSES TO CORNER.....

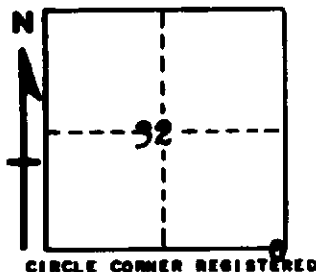

5" Cedar	-	N42E	-	31.7 ft
8" Spruce	-	N81W	-	39.9 ft
AND 7" Cedar	-	S42E	-	59.1 ft

DESCRIPTION IN DETAIL AS TO HOW CORNER WAS LOCATED AND IDENTIFIED OR RESTORED.

This corner was established while making a survey in this township. Set corner by proportionate measurement, midpoint on line, between section corners 1 mile east and 1 mile west. Unable to locate a previous corner. Falls about 20' north of center of fireline.

SURVEYOR'S SEAL

SIGNED Kenneth J. Oetting DATE 11/5/62  
REGISTERED LAND SURVEYOR