

*Witness*

RE MONUMENTATION  
LAND CORNER RECORDATION CERTIFICATE  
Filing Requirement of Act 74, Mich. P.A. 1970

For corners in

Cheboygan  
(County)

Located In:

Corner Code #

1. Public Land Survey

T 33N R 3W M-2  
T      R       
T 33 R R02 A-02  
T      R     

2. Property Controlling in Section

S      T      R     

3. Miscellaneous Property in Sec.

S      T      R       
S      T      R     

4. Lot No. \_\_\_\_\_, Recorded Plat \_\_\_\_\_

5. Private Claims \_\_\_\_\_

RECEIVED  
FBI RECORD

96 NOV 25 PM 12:46

*J. J. Gray*  
CLERK/REGISTER  
CHEBOYGAN COUNTY, MICHIGAN

Register of Deeds Stamp & File Number

I, Brian K. Fullford, in a field survey on August, 19 96 do hereby state that under requirements of P.A. 74, Michigan P.A. of 1970, the corner points mentioned in lines 1 and 2 above were in conformance with regulations and rules therefore as required in the current manual of survey instructions of the United States Department of the Interior, Bureau of Land Management or by a decree of a Court of Law and/or that the corner points mentioned in lines 3, 4 and 5 above were in conformance with the rules of the Michigan Board of Land Surveyors or by a Decree of a Court of Law; established, re-established, monumented, recovered, found as expressed below:

NOTE: Not more than 2 corners, all in the same town and range, may be recorded on this certificate.

A	B	C	D	E	F	G	H	I	J	K	L	M
1												
2	6	5	4	3	2	1						
3												
4	7	8	9	10	11	12						
5												
6	18	17	16	15	14	13						
7												
8	19	20	21	22	23	24						
9												
10	30	29	28	27	26	25						
11												
12	31	32	33	34	35	36						
13												

A. Description of original monument and accessories and/or subsequent restoration:  
G.L.O. 1976 Unrecorded Survey  
Set 1/4 Section Post By George Henning #2240  
13" Hemlock N79°E 40 Links Fnd 1" Pipe by MSHD  
30" Hemlock S83°W 15 Links 14" Elm S54°E 39.23'  
18" Elm S25°E 43.25'  
18 Elm S10°E 52.25'

SURVEY &  
REMONUMENTATION  
MAY 05 1997  
COMMISSION

B. Description of corner evidence found and/or method applied in restoring or reestablishing corner:  
Fnd 1" Pipe by MSHD (BENT)  
18" Elm S25°E 43.25' (Fnd Stump)  
18" Elm S10°E 52.25' (Fnd Stump)




LIBER 010 PAGE 190

C. Description of monument for corner and accessories established to perpetuate locating the position of the corner:

M-2 Fnd 1" Pipe by MSHD. Replaced 1" Pipe with 5/8" x 36" Bar with Remonumentation Cap. Accepted as a careful faithful re-establishment of the position of the original corner.

- 4" Basswood N62°E 30.84'
- 7" Basswood S64°E 16.56'
- 6" Cedar S66°W 9.43'
- 4" Cedar N73°W 16.82'

*Martin P. Rus*

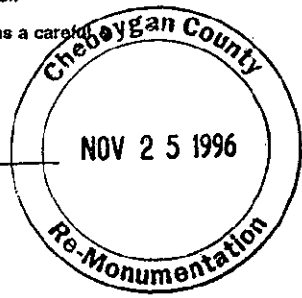

THIS CORNER IS ALSO DESIGNATED AS CORNER CODE #A-2, IN T33N-R2W.

Signed by Brian K. Fullford  
Surveyor's Michigan License No. 41099  
Brian K. Fullford, PS

Date 10/22/96