

**SURVEY & REMONUMENTATION**

MAY 15 1997

**COMMISSION**  
For corners in

**RE MONUMENTATION  
LAND CORNER RECORDATION CERTIFICATE**  
Filing Requirement of Act 74, Mich. P.A. 1970

RECEIVED  
FOR RECORD

96 NOV 25 PM 12: 49

*James Gray*  
CLERK/REGISTER  
CHEBOYGAN COUNTY, MICHIGAN

<u>Cheboygan</u> (County)	Located in:	Corner Code #
1. Public Land Survey	T <u>33N</u> R <u>3W</u>	M-5
	T <u>    </u> R <u>    </u>	
	T <u>33</u> R <u>02</u>	<u>A-05</u>
	T <u>    </u> R <u>    </u>	
2. Property Controlling in Section	S <u>    </u> T <u>    </u> R <u>    </u>	
3. Miscellaneous	S <u>    </u> T <u>    </u> R <u>    </u>	
Property in Sec.	S <u>    </u> T <u>    </u> R <u>    </u>	

Register of Deeds Stamp & File Number

4. Lot No. \_\_\_\_\_, Recorded Plat \_\_\_\_\_  
5. Private Claims \_\_\_\_\_

I, Brian K. Fullford, in a field survey on August, 19 96 do hereby state that under requirements of P.A. 74, Michigan P.A. of 1970, the corner points mentioned in lines 1 and 2 above were in conformance with regulations and rules therefore as required in the current manual of survey instructions of the United States Department of the Interior, Bureau of Land Management or by a decree of a Court of Law and/or that the corner points mentioned in lines 3, 4 and 5 above were in conformance with the rules of the Michigan Board of Land Surveyors or by a Decree of a Court of Law, established, re-established, monumented, recovered, found as expressed below:

NOTE: Not more than 2 corners, all in the same town and range, may be recorded on this certificate.

	A	B	C	D	E	F	G	H	I	J	K	L	M
1													
2	6		5		4		3		2		1		
3													
4	7		8		9		10		11		12		
5													
6	18		17		16		15		14		13		
7													
8	19		20		21		22		23		24		
9													
10	30		29		28		27		26		25		
11													
12	31		32		33		34		35		36		
13													

A. Description of original monument and accessories and/or subsequent restoration:  
G.L.O. 1923 Recorded County Surveyor Records 1947 LCRC  
Set Section Corner Post Survey by David Bowen Liber A, Page 63  
16" Sugar Maple N01°W 29 Links Cedar Post in Center of Road With R.R. Orlando Doyle #7319  
12" Sugar Maple S15°E 15 Links Spike in Top Fnd Wood Stake

Set Concrete Monument  
6" Elm (1 of 2) S21°W 73.50'  
10" Elm S89°30'W 74.65'  
7" Elm (1 of 3) N16°45'E 72.75'

B. Description of corner evidence found and/or method applied in restoring or reestablishing corner:  
Fnd Concrete Monument 2' West of 2-Track Centerline  
- No Witnesses found  
- Distance Checked Good To The North (2640' GLO, 2635.08' MEAS)




LIBER 010 PAGE 193

C. Description of monument for corner and accessories established to perpetuate locating the position of the corner:

M-5 Fnd Concrete Monument. Set Remonumentation Cap on Existing Monument. Accepted as a careful & faithful re-establishment of the position of the original corner.

2' W of Centerline 2-track  
4" Elm N44°E 25.00' Set Tag  
6" Willow S33°E 32.48' Set Tag  
7" Poplar S36°W59.24' Set Tag  
5" Elm N40°W 25.62 Set Tag  
Fence Corner West 19.5'

*Monroe O. Poley*

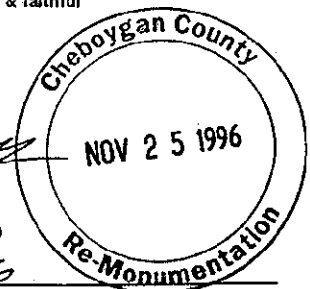

THIS CORNER IS ALSO DESIGNATED AS CORNER CODE #A-5, IN T33N-R2W

Signed by Brian K. Fullford  
Surveyor's Michigan License No. 41099  
Brian K. Fullford, PS

Date 10/22/96