

SURVEY & REMONUMENTATION

MAY 05 1997

**RE MONUMENTATION
LAND CORNER RECORDATION CERTIFICATE
Filing Requirement of Act 74, Mich. P.A. 1970**

COMMISSION

For corners in

<u>Cheboygan</u> (County)	Located In:	Corner Code #
1. Public Land Survey	T <u>33N</u> R <u>3W</u>	M-6
	T <u> </u> R <u> </u>	
	T <u>33</u> R <u>02</u>	<u>A-06</u>
	T <u> </u> R <u> </u>	
2. Property Controlling in Section	S <u> </u> T <u> </u> R <u> </u>	
	S <u> </u> T <u> </u> R <u> </u>	
3. Miscellaneous Property in Sec.	S <u> </u> T <u> </u> R <u> </u>	
	S <u> </u> T <u> </u> R <u> </u>	

RECEIVED FOR RECORD
96 NOV 25 PM 12: 50
James H. ...
CLERK/REGISTER
CHEBOYGAN COUNTY, MICHIGAN

Register of Deeds Stamp & File Number

4. Lot No. _____, Recorded Plat _____
5. Private Claims _____

I, Brian K. Fullford, in a field survey on August, 19 96 do hereby state that under requirements of P.A. 74, Michigan P.A. of 1970, the corner points mentioned in lines 1 and 2 above were in conformance with regulations and rules therefore as required in the current manual of survey instructions of the United States Department of the Interior, Bureau of Land Management or by a decree of a Court of Law and /or that the corner points mentioned in lines 3, 4 and 5 above were in conformance with the rules of the Michigan Board of Land Surveyors or by a Decree of a Court of Law, established, re-established, monumented, recovered, found as expressed below:

	A	B	C	D	E	F	G	H	I	J	K	L	M
1													
2	6	5	4	3	2	1							
3													
4	7	8	9	10	11	12							
5													
6	18	17	16	15	14	13							
7													
8	19	20	21	22	23	24							
9													
10	30	29	28	27	26	25							
11													
12	31	32	33	34	35	36							
13													

NOTE: Not more than 2 corners, all in the same town and range, may be recorded on this certificate.

A. Description of original monument and accessories and/or subsequent restoration:

G.L.O.	1947 LCRC	1954 LCRC	1976 Unrecorded Survey
Set 1/4 Section Post	Liber A, Page 63	County Surveyor Corner Records	R.C. Dunn #12020
12" Sugar Maple S06°W 23 Links	Orlando Doyle #7319	Orlando Doyle #7319	Fnd Concrete Mon.
10" Sugar Maple N34°E 5 Links	Fnd Iron Marked Post	Fnd Concrete Mon.	Iron Set 33' East
	Set Concrete Mon.	1" Pipe S62°W On N & S Fence	
	8" Elm N85°E 17.51'	Line 17.8' South of Conc. Mon. F.P.	
	8" Elm N16°E 30.56'	8" Elm S68° 30'E 56.50'	
	9" Elm S27°E 27.20'	6" Elm N60°E 83.88'	

B. Description of corner evidence found and/or method applied in restoring or reestablishing corner:

Concrete Monument on New E & W Fence
Fnd 5/8" Bar 33' East
Fnd Old Fence Line to South at 33' West
Fnd 1" Pipe S62°W 37.3', on old N & S Fence Line




LIBER 010 PAGE 194

C. Description of monument for corner and accessories established to perpetuate locating the position of the corner:

M-6 Fnd Concrete Monument. Set Remonumentation Cap on Existing Monument. Accepted as a careful & faithful re-establishment of the position of the original corner.

5/8" Bar East 33"
7" Poplar N42°E 23.69' Set Tag
Fence Post East 13.80' Set Tag
Fence Post West 23.08' Set Tag
18" Basswood N54°W 61.00' Fnd 60p nail
1" Pipe S62°W 37.30'

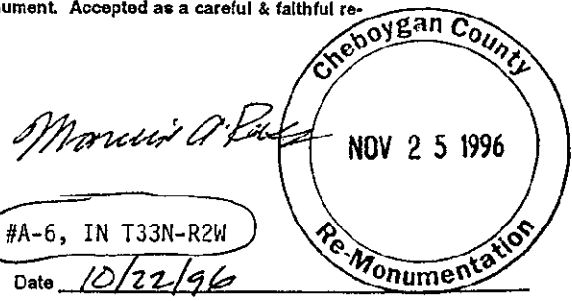

THIS CORNER IS ALSO DESIGNATED AS CORNER CODE #A-6, IN T33N-R2W

Signed by Brian K. Fullford
Surveyor's Michigan License No. 41099
Brian K. Fullford, PS

Date 10/22/96