

**SURVEY & REMONUMENT**

MAY 15 1977

**RE MONUMENTATION  
LAND CORNER RECORDATION CERTIFICATE  
Filing Requirement of Act 74, Mich. P.A. 1970**

RECEIVED  
FOR RECORD

96 NOV 25 PM 12: 52

*James Gray*  
CLERK/REGISTER  
CHEBOYGAN COUNTY, MICHIGAN

For corners in

Cheboygan  
(County)

Located in:

Corner Code #

- |                                    |   |             |
|------------------------------------|---|-------------|
| 1. Public Land Survey              | T <u>33N</u> R <u>3W</u>                  | M-8         |
|                                    | T <u>33</u> R <u>02</u>                   | <u>A-08</u> |
| 2. Property Controlling in Section | S <u>    </u> T <u>    </u> R <u>    </u> | <u>    </u> |
| 3. Miscellaneous Property in Sec.  | S <u>    </u> T <u>    </u> R <u>    </u> | <u>    </u> |

Register of Deeds Stamp & File Number

4. Lot No. \_\_\_\_\_, Recorded Plat \_\_\_\_\_  
5. Private Claims \_\_\_\_\_

I, Brian K. Fullford, in a field survey on August, 19 96 do hereby state that under requirements of P.A. 74, Michigan P.A. of 1970, the corner points mentioned in lines 1 and 2 above were in conformance with regulations and rules therefore as required in the current manual of survey instructions of the United States Department of the Interior, Bureau of Land Management or by a decree of a Court of Law and/or that the corner points mentioned in lines 3, 4 and 5 above were in conformance with the rules of the Michigan Board of Land Surveyors or by a Decree of a Court of Law; established, re-established, monumented, recovered, found as expressed below:

NOTE: Not more than 2 corners, all in the same town and range, may be recorded on this certificate.

A	B	C	D	E	F	G	H	I	J	K	L	M
1												
2	6	5	4	3	2	1						
3												
4	7	8	9	10	11	12						
5												
6	10	17	16	15	14	13						
7												
8	19	20	21	22	23	24						
9												
10	30	29	28	27	26	25						
11												
12	31	32	33	34	35	36						
13												

A. Description of original monument and accessories and/or subsequent restoration:  
G.L.O. 1983 Unrecorded Survey  
1/4 Section Corner R.C. Dunn #12020  
Corner Identified as East 1/4 Corner  
Section 19, T33N-R2W

B. Description of corner evidence found and/or method applied in restoring or reestablishing corner:  
No Evidence of Corner or Accessories Found  
Set By Single Proportionate Measurement Between  
NE & SE Corner Section 24, Corner Falls 3.5' +/-  
East of 2-track centerline




LIBER 010 PAGE 196

C. Description of monument for corner and accessories established to perpetuate locating the position of the corner:

M-8 Set 5/8" x 36" Rebar with Remon Cap. Accepted as a careful & faithful re-establishment of the position of the original corner.

- 5" MAPLE N49°E 10.75' w/ tag
- 10" MAPLE S66°E 29.86' w/ tag
- 18" BEECH S46°W 26.73' w/ tag
- 5" MAPLE N42°W 25.45' w/tag
- NORTH/SOUTH FENCE 35' EAST

*Marvin A. Bess*

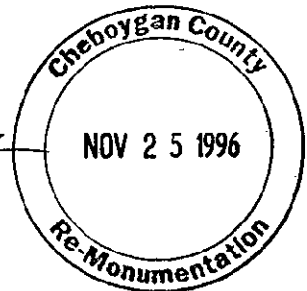

THIS CORNER IS ALSO DESIGNATED AS CORNER CODE #A-8, IN T33N-R2W

Signed by Brian K. Fullford  
Surveyor's Michigan License No. 41099  
Brian K. Fullford, PS

Date 10/22/96