

REMONUMENTATION

MAY 05 1997

COMMISSION

RE MONUMENTATION LAND CORNER RECORDATION CERTIFICATE Filing Requirement of Act 74, Mich. P.A. 1970

RECEIVED FOR RECORD

96 NOV 25 PM 12: 54

Jessie Gray CLERK/REGISTER CHEBOYGAN COUNTY, MICHIGAN

For corners in

Cheboygan (County)

Located In:

Corner Code #

1. Public Land Survey

T 33N R 3W M-10 T R T 33 R 02 A-10 T R T R S T R S T R S T R

2. Property Controlling in Section

3. Miscellaneous Property in Sec.

Register of Deeds Stamp & File Number

4. Lot No. , Recorded Plat 5. Private Claims

Brian K. Fullford in a field survey on August 19 96 do hereby state that under requirements of P.A. 74, Michigan P.A. of 1970, the corner points mentioned in lines 1 and 2 above were in conformance with regulations and rules therefore as required in the current manual of survey instructions of the United States Department of the Interior, Bureau of Land Management or by a decree of a Court of Law and/or that the corner points mentioned in lines 3, 4 and 5 above were in conformance with the rules of the Michigan Board of Land Surveyors or by a Decree of a Court of Law; established, re-established, monumented, recovered, found as expressed below.

NOTE: Not more than 2 corners, all in the same town and range, may be recorded on this certificate.

Grid table with columns A-M and rows 1-13. Cell (10, 25) contains a black dot.

A. Description of original monument and accessories and/or subsequent restoration:

G.L.O. Set 1/4 Section Post 14" Sugar Maple S20°E 24 Links 10" Sugar Maple N46°W 19 Links

B. Description of corner evidence found and/or method applied in restoring or reestablishing corner:

No Evidence Found Set By Single Proportionate Measurement Between NE & SE Corners of Section 25

LIBER 010 PAGE 198




C. Description of monument for corner and accessories established to perpetuate locating the position of the corner:

M-10 Set 5/8" x 36" Rebar with Remonumentation Cap. Accepted as a careful & faithful re-establishment of the position of the original corner.

- 6" Cherry N25°E 53.14' w/tag 8" Cherry clump S35°E 4.35' w/tag 7" Spruce S14°W 40.78' w/ tag 6" Cherry Clump S81°W 26.82' w/ tag Intersection of Perry Road & 2 Track N60°E 42.5'

THIS CORNER IS ALSO DESIGNATED AS CORNER CODE #A-10, IN T33N-R2W.

Maurice A. P...

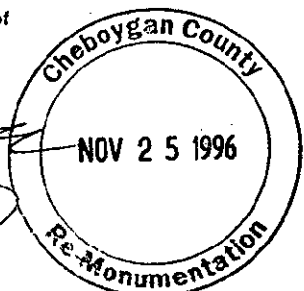

Signed by Brian K. Fullford Surveyor's Michigan License No. 41099 Brian K. Fullford, PS

Date 10/22/96