

MAY 05 1997

COMMISSION

For corners in

Cheboygan

(County)

Located In:

Corner Code #

1. Public Land Survey

T 33N R 3W M-12
T R
T 33 R 02 A-12
T R

2. Property Controlling in Section

S T R
S T R

3. Miscellaneous Property in Sec.

S T R
S T R

RECEIVED FOR RECORD

96 NOV 25 PM 12:56

Josmie Leroy
CLERK/REGISTER
CHEBOYGAN COUNTY, MICHIGAN

Register of Deeds Stamp & File Number

4. Lot No. _____, Recorded Plat _____

5. Private Claims _____

I, Brian K. Fullford, in a field survey on August 19 96 do hereby state that under requirements of P.A. 74, Michigan P.A. of 1970, the corner points mentioned in lines 1 and 2 above were in conformance with regulations and rules therefore as required in the current manual of survey instructions of the United States Department of the Interior, Bureau of Land Management or by a decree of a Court of Law and/or that the corner points mentioned in lines 3, 4 and 5 above were in conformance with the rules of the Michigan Board of Land Surveyors or by a Decree of a Court of Law; established, re-established, monumented, recovered, found as expressed below.

NOTE: Not more than 2 corners, all in the same town and range, may be recorded on this certificate.

	A	B	C	D	E	F	G	H	I	J	K	L	M
1													
2	6	5	4	3	2	1							
3													
4	7	8	9	10	11	12							
5													
6	10	17	16	15	14	13							
7													
8	19	20	21	22	23	24							
9													
10	30	29	28	27	26	25							
11													
12	31	32	33	34	35	36							
13													

A. Description of original monument and accessories and/or subsequent restoration:

- G.L.O.
- ~~Set 1/4 Section Post~~ 16" CEDAR 1/4 SECTION CORNER BKF 12/4/96
- ~~10" Pine N45°E 14 Links~~
- ~~8" Fir S25°W 10 Links~~

B. Description of corner evidence found and/or method applied in restoring or reestablishing corner:

- Found 1/2" Bar Leaning, N44°E 0.68' of Single Proportion Position
- Between NE & SE Section Corners
- 10" Cedar S36°W 20.05' w/60p nail
- 11" Cedar N46°E 16.65' w/60p nail
- Squared off Cedar Stake Laying on Ground
- Old Fence to North & to East




LIBER 010 PAGE 200

C. Description of monument for corner and accessories established to perpetuate locating the position of the corner:

- M-12 Replaced 1/2" Bar with 5/8" x 36" Iron Bar with Remonumentation Cap. Accepted as a careful & faithful re-establishment of the position of the original corner.
- 5" Cedar N03°E 26.78" Set Tag
- 11" Cedar N46°E 16.65' w/60p nail
- 10" Cedar S36°W 20.05' w/60p nail
- 10" Fir N19°W 25.07' Set Tag
- 280' +/- East of Old R.R. Grade

Marcus P. Rose

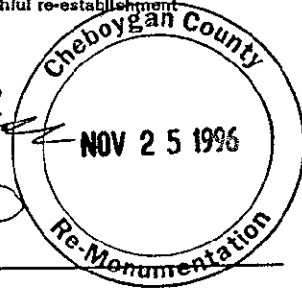

THIS CORNER IS ALSO DESIGNATED AS CORNER CODE #A-12, IN T33N-R2W.

Signed by *Brian K. Fullford*

Date 10/22/96

Surveyor's Michigan License No. 41099

Brian K Fullford PS