

1993

COMMISSION

CHEBOYGAN COUNTY REMONUMENTATION CORNER
LAND CORNER RECORDATION CERTIFICATE
Filing Requirement of Act 74, Mich. P.A. 1970

RECEIVED FOR RECORD
93 DEC 29 PM 2:23

James Gray
CLERK/REGISTER
CHEBOYGAN COUNTY, MICHIGAN

For corners in CHEBOYGAN (County)

	Located In:	Corner Code #
1. Public Land Survey	T <u>33N</u> R <u>2W</u>	<u>M-3</u>
	T _____ R _____	_____
	T _____ R _____	_____
	T _____ R _____	_____
2. Property Controlling in Section	S _____ T _____ R _____	_____
	S _____ T _____ R _____	_____
3. Miscellaneous Property in Sec.	S _____ T _____ R _____	_____
	S _____ T _____ R _____	_____
4. Lot No. _____, Recorded Plat _____		
5. Private Claims _____		

Register of Deeds Stamp & File Number

	A	B	C	D	E	F	G	H	I	J	K	L	M
2	6		5		4		3		2		1		
3													
4	7		8		9		10		11		12		
5													
6	18		17		16		15		14		13		
7													
8	19		20		21		22		23		24		
9													
10	30		29		28		27		26		25		
11													
12	31		32		33		34		35		36		
13													

I, Richard C. Dunn, in a field survey on November 1 - 12, 19 93, do hereby certify that under requirements of P.A. 74, Michigan P.A. of 1970, the corner points mentioned in lines 1 and 2 above were in conformance with regulations and rules therefore as required in the current manual of survey instructions of the United States Department of the Interior, Bureau of Land Management or by a decree of a Court of Law and/or that the corner points mentioned in lines 3, 4 and 5 above were in conformance with the rules of the Michigan Board of Land Surveyors or by a Decree of a Court of Law; established, re-established, monumented, re-monumented, recovered, found as expressed below:

NOTE: Not more than 4 corners, all in the same town and range, may be recorded on this certificate.

A. Description of original monument and accessories and/or subsequent restoration:


G.L.O. John Mullett 1840
Set Post corner Sections
1& 12 (T33N-R2W) and
Sections 6 & 7 (T33N-R1W)
10" Cedar, N70°E.8.
10" Cedar, S57°W.27.

Schweigert #6525, 1956. Found
squared post and replaced with
concrete monument.
14" W. Pine, S3½°W.34.3'
26" W. Pine, N37½°W.40.9'

Dean Delamater #5778,
1962. Recorded Schweigert corner.
14" W. Pine, 3½°W.34.3'
26" W. Pine, 37½°W, 40.9'

B. Description of corner evidence found and/or method applied in restoring or reestablishing corner:

Found concrete monument set by Schweigert and recorded by Dean Delamater in Liber A, Page 49, Cheboygan County L.C.R. Records.

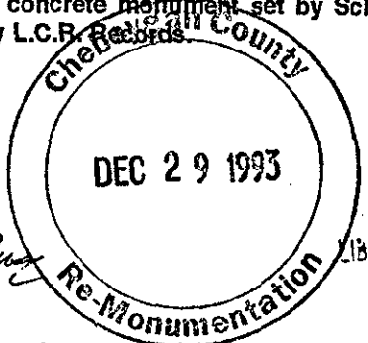

LIBER 010 PAGE 34

C. Description of monument for corner and accessories established to perpetuate locating the position of the corner:

M-3 Found Concrete Monument per Liber A, Page 49, Cheboygan County Records, and is accepted as a careful and faithful reestablishment of the position of the original corner.
8" B. Ash S42°E 8.36' Set 60 d Spike
8" B. Ash N42°E 29.0' Set 60 d Spike
26" W. Pine N42°W 34.82' Set 60 d Spike
10" Twin Maple S68°W 35.56' Set 60 d Spike

Signed by *Richard C. Dunn* Date December 29, 1993
Surveyor's Michigan License No. 12020