

1993

COMMISSION

CHEBOYGAN COUNTY REMONUMENTATION CORNER
LAND CORNER RECORDATION CERTIFICATE
Filing Requirement of Act 74, Mich. P.A. 1970

RECEIVED FOR RECORD

93 DEC 29 PM 2:21

James Gray
CLERK/REGISTER
CHEBOYGAN COUNTY, MICHIGAN

For corners in

<u>CHEBOYGAN</u> (County)	Located In:	Corner Code #
1. Public Land Survey	T <u>33N</u> R <u>2W</u>	<u>M-4</u>
	T _____ R _____	_____
	T _____ R _____	_____
	T _____ R _____	_____
2. Property Controlling in Section	S _____ T _____ R _____	_____
	S _____ T _____ R _____	_____
3. Miscellaneous Property in Sec.	S _____ T _____ R _____	_____
	S _____ T _____ R _____	_____

Register of Deeds Stamp & File Number

- 4. Lot No. _____, Recorded Plat _____
- 5. Private Claims _____

A	B	C	D	E	F	G	H	I	J	K	L	M
2	6	5	4	3	2	1						
3												
4	7	8	9	10	11	12						
5												
6	18	17	16	15	14	13						
7												
8	19	20	21	22	23	24						
9												
10	30	29	28	27	26	25						
11												
12	31	32	33	34	35	36						
13												

I, Richard C. Dunn, in a field survey on November 1 - 12, 19 93, do hereby certify that under requirements of P.A. 74, Michigan P.A. of 1970, the corner points mentioned in lines 1 and 2 above were in conformance with regulations and rules therefore as required in the current manual of survey instructions of the United States Department of the Interior, Bureau of Land Management or by a decree of a Court of Law and/or that the corner points mentioned in lines 3, 4 and 5 above were in conformance with the rules of the Michigan Board of Land Surveyors or by a Decree of a Court of Law; established, re-established, monumented, re-monumented, recovered, found as expressed below:

NOTE: Not more than 4 corners, all in the same town and range, may be recorded on this certificate.

A. Description of original monument and accessories and/or subsequent restoration:


G.L.O. John Mullett 1840
Set ¼ Sec. Post,
Section 12 (T33N-R2W) and
Section 7 (T33N-R1W)
10" Beech, N82°W.20.
10" Beech, S65°E.10.

Schweigert #6525, 1958.
Set Monument.
Steel Fence Post S45°W.16.5'
Steel Fence Post N45°W.16.5'


Dean Delamater #5778,
1962. Recorded Schweigert corner.
Steel Fence Post S45°W.16.5'
Steel Fence Post N45°W.16.5'

B. Description of corner evidence found and/or method applied in restoring or reestablishing corner:

Found concrete monument set by Schweigert and recorded by Dean Delamater in Liber A, Page 60, Cheboygan County L.C.R. Records.

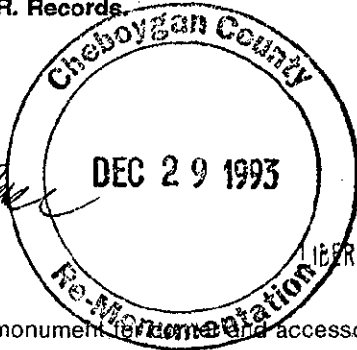

010 PAGE 32

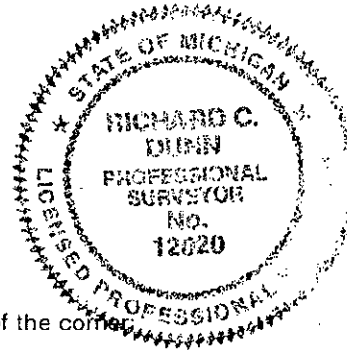

C. Description of monument, accessories established to perpetuate locating the position of the corner:

M-4 Found Concrete Monument per Liber A, Page 60, Cheboygan County Records, and is accepted as a careful and faithful reestablishment of the position of the original corner.

Steel Fence Post	S45°W	16.5'	
Steel Fence Post	N45°W	16.5'	
16" Triple Maple	S72°E	12.36'	Set 60 d Spike
3" White Poine	N46°E	20.2'	Set 60 d Spike

Signed by *Richard C. Dunn*

Date December 29, 1993

Surveyor's Michigan License No. 12020