

1993

CHEBOYGAN COUNTY REMONUMENTATION CORNER

LAND CORNER RECORDATION CERTIFICATE 93 DEC 29 PM 2: 27
 Filing Requirement of Act 74, Mich. P.A. 1970

RECEIVED
 FOR RECORD

James Gray
 CLERK/REGISTER
 CHEBOYGAN COUNTY, MICHIGAN

COMMISSION
 For corners in
CHEBOYGAN
 (County)

Located In: Corner Code #

1. Public Land Survey	T <u>33N</u> R <u>2W</u>	<u>M-5</u>
	T _____ R _____	_____
	T _____ R _____	_____
	T _____ R _____	_____
2. Property Controlling in Section	S _____ T _____ R _____	_____
	S _____ T _____ R _____	_____
3. Miscellaneous Property in Sec.	S _____ T _____ R _____	_____
	S _____ T _____ R _____	_____

Register of Deeds Stamp & File Number

4. Lot No. _____, Recorded Plat _____
 5. Private Claims _____

	A	B	C	D	E	F	G	H	I	J	K	L	M
2	6	5	4	3	2	1							
3													
4	7	8	9	10	11	12							
5													
6	18	17	16	15	14	13							
7													
8	19	20	21	22	23	24							
9													
10	30	29	28	27	26	25							
11													
12	31	32	33	34	35	36							
13													

I, Richard C. Dunn, in a field survey on November 1 - 12, 19 93, do hereby certify that under requirements of P.A. 74, Michigan P.A. of 1970, the corner points mentioned in lines 1 and 2 above were in conformance with regulations and rules therefore as required in the current manual of survey instructions of the United States Department of the Interior, Bureau of Land Management or by a decree of a Court of Law and/or that the corner points mentioned in lines 3, 4 and 5 above were in conformance with the rules of the Michigan Board of Land Surveyors or by a Decree of a Court of Law; established, re-established, monumented, re-monumented, recovered, found as expressed below:

NOTE: Not more than 4 corners, all in the same town and range, may be recorded on this certificate.

A. Description of original monument and accessories and/or subsequent restoration:


G.L.O. John Mullett 1840
 Set Post corner Sections
 12 & 13 (T33N-R2W) and
 Sections 7 & 18 (T33N-R1W)
 8" Fir N54°E.14.
 8" Spruce S42°W.5.

Schweigert #6525, 1958.
 Found 1 1/4" Pipe. Set Concrete
 Monument. Delamater recorded, 1962.
 Steel Fence Post S45°E.33.0'
 Steel Fence Post N45°E.33.0'


Delmer Porter #15410, 1973.
 Found Concrete Monument.
 Steel Fence Post S60°E.16.77'
 Steel Fence Post N45°E.16.43'
 4" Dead Cedar S60°W.3.67'

B. Description of corner evidence found and/or method applied in restoring or reestablishing corner:

Found 4" Concrete Monument with RLS Cap #6525, as recorded in Liber A, Page 59, and as recorded by Delmer Porter #15410, in Book 1, Page 93, Cheboygan County L.C.R. Records.

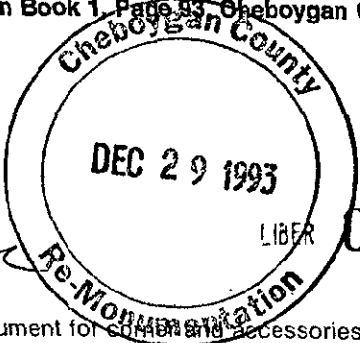

LIBER 010 PAGE 38

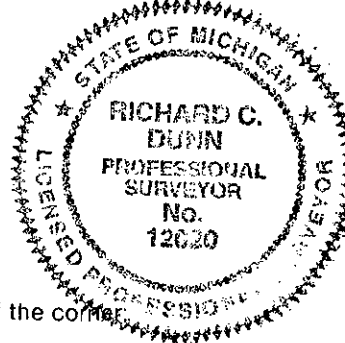

C. Description of monument for corners and accessories established to perpetuate locating the position of the corner:

M-5 Found 4" Concrete Monument per Liber A, Page 59, Cheboygan County Records, and set 3" aluminum remon. cap and is accepted as a careful and faithful reestablishment of the position of the original corner.
 Steel Fence Post S60°E 16.77'
 Steel Fence Post N45°E 16.43'
 Steel Fence Post N45°W 16.45'
 Steel Fence Post S45°W 16.45'

Signed by *Richard C. Dunn* Date December 29, 1993
 Surveyor's Michigan License No. 12020