

1993

COMMISSION

CHEBOYGAN COUNTY REMONUMENTATION CORNER
LAND CORNER RECORDATION CERTIFICATE
Filing Requirement of Act 74, Mich. P.A. 1970

RECEIVED
FOR RECORD

93 DEC 29 PM 2:31

James Gray
CLERK/REGISTER
CHEBOYGAN COUNTY, MICHIGAN

For corners in
CHEBOYGAN
(County)

Located In:

Corner Code #

- 1. Public Land Survey T 33N R 2W M-16 M/b
- T _____ R _____
- T _____ R _____
- T _____ R _____
- 2. Property Controlling S _____ T _____ R _____
- in Section S _____ T _____ R _____
- 3. Miscellaneous S _____ T _____ R _____
- Property in Sec. S _____ T _____ R _____

Register of Deeds Stamp & File Number

- 4. Lot No. _____, Recorded Plat _____
- 5. Private Claims _____


	A	B	C	D	E	F	G	H	I	J	K	L	M
2	6	5	4	3	2	1							
3													
4	7	8	9	10	11	12							
5													
6	18	17	16	15	14	13							
7													
8	19	20	21	22	23	24							
9													
10	30	29	28	27	26	25							
11													
12	31	32	33	34	35	36							
13													

I, Richard C. Dunn, in a field survey on November 1 - 12, 19 93, do hereby certify that under requirements of P.A. 74, Michigan P.A. of 1970, the corner points mentioned in lines 1 and 2 above were in conformance with regulations and rules therefore as required in the current manual of survey instructions of the United States Department of the Interior, Bureau of Land Management or by a decree of a Court of Law and/or that the corner points mentioned in lines 3, 4 and 5 above were in conformance with the rules of the Michigan Board of Land Surveyors or by a Decree of a Court of Law; established, re-established, monumented, re-monumented, recovered, found as expressed below:

NOTE: Not more than 4 corners, all in the same town and range, may be recorded on this certificate.


A. Description of original monument and accessories and/or subsequent restoration:

G.L.O. John Mullett 1840
Set 1/4 Sec. Post Section
13 (T33N-R2W) and Section
18, (T33N-R1W)
12" Beech, N20°W.24.
6" Beech S54°E.21.

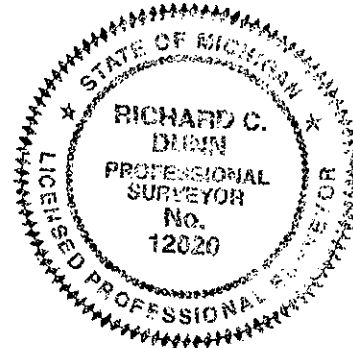

B. Description of corner evidence found and/or method applied in restoring or reestablishing corner:

Established corner midway between the NE and SE corners of Section 13 T33N-R2W, November, 1993.

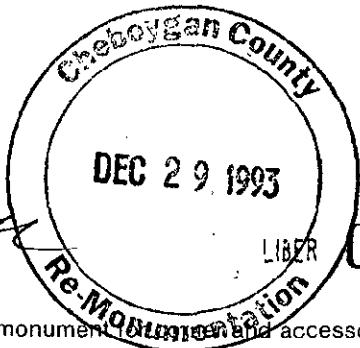

Morvin A. Pusey LIBER 010 PAGE 39

C. Description of monument and accessories established to perpetuate locating the position of the corner:

- M-6 Set 5/8" x 30" Iron Rod and 3" Remon. Cap midway between the NE and SE corners of Section 13, T33N-R2W, November, 1993, and is accepted as a careful and faithful reestablishment of the position of the original corner.
- 30" Twin Ash N06°W 36.78' Set 60 d Spike
- 10" Maple S15°E 35.44' Set 60 d Spike
- 16" Oak S79°E 84.92' Set 60 d Spike
- 6" Maple N33°E 68.85' Set 60 d Spike

Signed by *Richard C. Dunn* Date December 29, 1993
Surveyor's Michigan License No. 12020