

1993

CHEBOYGAN COUNTY REMONUMENTATION CORNER  
 LAND CORNER RECORDATION CERTIFICATE  
 Filing Requirement of Act 74, Mich. P.A. 1970

RECEIVED FOR RECORD

93 DEC 29 PM 2:32

COMMISSION

For corners in  
 CHEBOYGAN  
 (County)

Located In: Corner Code  $\neq$

- |                                    |   |            |   |           |            |
|------------------------------------|---|------------|---|-----------|------------|
| 1. Public Land Survey              | T | <u>33N</u> | R | <u>2W</u> | <u>M-7</u> |
|                                    | T |            | R |           |            |
|                                    | T |            | R |           |            |
|                                    | T |            | R |           |            |
| 2. Property Controlling in Section | S |            | T |           | R          |
|                                    | S |            | T |           | R          |
| 3. Miscellaneous Property in Sec.  | S |            | T |           | R          |
|                                    | S |            | T |           | R          |

*Josanna Spang*  
 CLERK/REGISTER  
 CHEBOYGAN COUNTY, MICHIGAN

Register of Deeds Stamp & File Number

4. Lot No. \_\_\_\_\_, Recorded Plat \_\_\_\_\_  
 5. Private Claims \_\_\_\_\_

	A	B	C	D	E	F	G	H	I	J	K	L	M
2	6		5		4		3		2		1		
3													
4	7		8		9		10		11		12		
5													
6	18		17		16		15		14		13		
7													
8	19		20		21		22		23		24		
9													
10	30		29		28		27		26		25		
11													
12	31		32		33		34		35		36		
13													

I, Richard C. Dunn, in a field survey on November 1 - 12, 19 93, do hereby certify that under requirements of P.A. 74, Michigan P.A. of 1970, the corner points mentioned in lines 1 and 2 above were in conformance with regulations and rules therefore as required in the current manual of survey instructions of the United States Department of the Interior, Bureau of Land Management or by a decree of a Court of Law and/or that the corner points mentioned in lines 3, 4 and 5 above were in conformance with the rules of the Michigan Board of Land Surveyors or by a Decree of a Court of Law; established, re-established, monumented, re-monumented, recovered, found as expressed below:

NOTE: Not more than 4 corners, all in the same town and range, may be recorded on this certificate.

A. Description of original monument and accessories and/or subsequent restoration:


G.L.O. John Mullett 1840  
 Set Post corner Sections  
 13 & 24 (T33N-R2W) and  
 Section 18 & 19 (T33N-R1W)  
 8" Beech N33°W.31.  
 12" Maple S65°E.27.

Delmer Porter #15410, 1973.  
 Set 4" Concrete monument.  
 16" Beech N25°W.19.57'  
 14" Hemlock N50°E.57.71'  
 10" Maple S20°W.40.32'



B. Description of corner evidence found and/or method applied in restoring or reestablishing corner:

Found 4" Concrete Monument, with RLS cap #15410, set by single proportionate measurement between M-5 and M-9, by Delmer Porter #15410 as recorded in Book 1, Page 93, Cheboygan County L.C.R. Records.

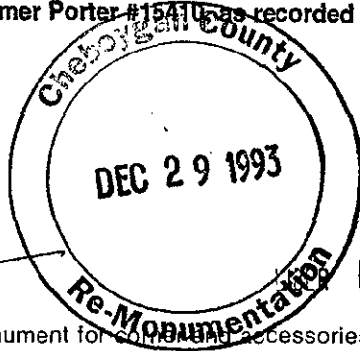

010 PAGE 40

C. Description of monument for corner and accessories established to perpetuate locating the position of the corner:

M-7 Found 4" Concrete Monument per Book 1, Page 93, Cheboygan County Records, and is accepted as a careful and faithful reestablishment of the position of the original corner.

20" Beech	N31°W	19.57'	Set 60 d Spike
16" Hemlock	N64°E	57.78'	Set 60 d Spike
12" Maple	S27°W	40.32'	Set 60 d Spike
8" Maple	S76°E	21.04'	Set 60 d Spike

Signed by *Richard C. Dunn*

Date December 29, 1993

Surveyor's Michigan License No. 12020