

1993

COMMISSION

CHEBOYGAN COUNTY REMONUMENTATION CORNER
LAND CORNER RECORDATION CERTIFICATE 93 DEC 29 PM 2:33
Filing Requirement of Act 74, Mich. P.A. 1970

RECEIVED FOR RECORD

James Spray
CLERK/REGISTER
CHEBOYGAN COUNTY, MICHIGAN

For corners in CHEBOYGAN (County)

	Located In:	Corner Code =#
1. Public Land Survey	T <u>33N</u> R <u>2W</u>	<u>M-8</u>
	T _____ R _____	_____
	T _____ R _____	_____
	T _____ R _____	_____
2. Property Controlling in Section	S _____ T _____ R _____	_____
	S _____ T _____ R _____	_____
3. Miscellaneous Property in Sec.	S _____ T _____ R _____	_____
	S _____ T _____ R _____	_____
4. Lot No. _____, Recorded Plat _____		
5. Private Claims _____		

Register of Deeds Stamp & File Number

I, Richard C. Dunn, in a field survey on November 1 - 12, 1993, do hereby certify that under requirements of P.A. 74, Michigan P.A. of 1970, the corner points mentioned in lines 1 and 2 above were in conformance with regulations and rules therefore as required in the current manual of survey instructions of the United States Department of the Interior, Bureau of Land Management or by a decree of a Court of Law and/or that the corner points mentioned in lines 3, 4 and 5 above were in conformance with the rules of the Michigan Board of Land Surveyors or by a Decree of a Court of Law; established, re-established, monumented, re-monumented, recovered, found as expressed below:

	A	B	C	D	E	F	G	H	I	J	K	L	M
2	6	5	4	3	2	1							
3													
4	7	8	9	10	11	12							
5													
6	18	17	16	15	14	13							
7													
8	19	20	21	22	23	24							
9													
10	30	29	28	27	26	25							
11													
12	31	32	33	34	35	36							
13													

NOTE: Not more than 4 corners, all in the same town and range, may be recorded on this certificate.

A. Description of original monument and accessories and/or subsequent restoration:


G.L.O. John Mullett 1840
Set 1/4 Section post,
Section 24 (T33N-R2W) and
Section 19 (T33N-R1W)
16" Maple N58°E.12.
8" Maple S61°E.27.

Delmer Porter #15410, 1973.
Set 4" Concrete Monument.
6" Maple S65°W.23.98'
12" Basswood N30°W.19.75'
12" Beech N60°E.42.93'



B. Description of corner evidence found and/or method applied in restoring or reestablishing corner:

Found 4" Concrete Monument set by Delmer Porter #15410 by single proportion between M-5 and M-9, as recorded in Book 1, Page 93, Cheboygan County L.C.R. Records.

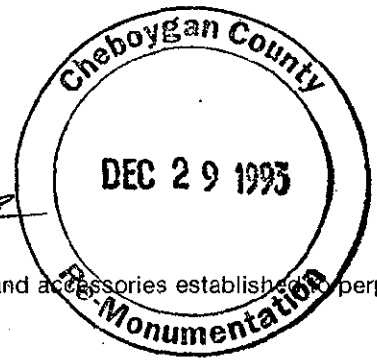

C. Description of monument for corner and accessories established to perpetuate locating the position of the corner:

M-8 Found 4" Concrete Monument per Book 1, Page 93, Cheboygan County Records, and is accepted as a careful and faithful reestablishment of the position of the original corner.

12" Maple	S04°E	24.16'	Set 60 d Spike
8" Maple	S87°W	48.34'	Set 60 d Spike
6" Maple	N74°E	8.57'	Set 60 d Spike
1/2" Bar & Cap #12020	N42°W	18.06'	

LIBER 010 PAGE 41

Signed by Richard C. Dunn

Date December 29, 1993

Surveyor's Michigan License No. 12020