

1993

COMMISSION

CHEBOYGAN COUNTY REMONUMENTATION CORNER
LAND CORNER RECORDATION CERTIFICATE
Filing Requirement of Act 74, Mich. P.A. 1970

RECEIVED FOR RECORD

93 DEC 29 PM 2:34

James Gray
CLERK/REGISTER
CHEBOYGAN COUNTY, MICHIGAN

For corners in
CHEBOYGAN
(County)

Located In: Corner Code #

- | | | |
|---------------------------------------|--------------------------|------------|
| 1. Public Land Survey | T <u>33N</u> R <u>2W</u> | <u>M-9</u> |
| | T _____ R _____ | _____ |
| | T _____ R _____ | _____ |
| | T _____ R _____ | _____ |
| 2. Property Controlling in Section | S _____ T _____ R _____ | _____ |
| | S _____ T _____ R _____ | _____ |
| 3. Miscellaneous Property in Sec. | S _____ T _____ R _____ | _____ |
| | S _____ T _____ R _____ | _____ |
| 4. Lot No. _____, Recorded Plat _____ | | |
| 5. Private Claims _____ | | |

Register of Deeds Stamp & File Number

A	B	C	D	E	F	G	H	I	J	K	L	M
2	6	5	4	3	2	1						
3												
4	7	8	9	10	11	12						
5												
6	18	17	16	15	14	13						
7												
8	19	20	21	22	23	24						
9												
10	30	29	28	27	26	25						
11												
12	31	32	33	34	35	36						
13												

I, Richard C. Dunn, in a field survey on November 1 - 12, 19 93, do hereby certify that under requirements of P.A. 74, Michigan P.A. of 1970, the corner points mentioned in lines 1 and 2 above were in conformance with regulations and rules therefore as required in the current manual of survey instructions of the United States Department of the Interior, Bureau of Land Management or by a decree of a Court of Law and/or that the corner points mentioned in lines 3, 4 and 5 above were in conformance with the rules of the Michigan Board of Land Surveyors or by a Decree of a Court of Law; established, re-established, monumented, re-monumented, recovered, found as expressed below:

NOTE: Not more than 4 corners, all in the same town and range, may be recorded on this certificate.


A. Description of original monument and accessories and/or subsequent restoration:

- | | |
|---|---|
| G.L.O. John Mullett 1840
Set Post Corner Sections
24 & 25 (T33N-R2W) and
Sections 19 & 30 (T33N-R1W)
20" Maple S21°E.28.
10" Maple N21°W.10. | Delmer Porter #15410, 1972.
Found 2" Pipe in 8" x 8"
Concrete Block.
7" Maple N80°W.31'
12" Basswood N10°W.23.9'
16" Hemlock S7°E.44.83' |
|---|---|



B. Description of corner evidence found and/or method applied in restoring or reestablishing corner:

Found 2" Pipe in 8" x 8" Concrete Block as recorded in Liber 1, Page 93, Cheboygan County L.C.R. Records.

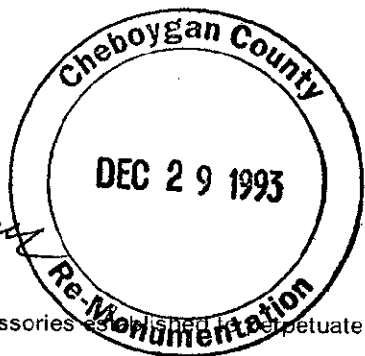

C. Description of monument for corner and accessories to perpetuate locating the position of the corner:

- M-9 Found 2" Pipe in 8" x 8" Concrete Block per Liber 1, Page 93, Cheboygan County Records, replaced with 5/8" x 30" Iron Bar and 3" aluminum remon. cap and is accepted as a careful and faithful reestablishment of the position of the original corner.
- | | | | |
|-------------|-------|--------|----------------|
| 20" Hemlock | S70°E | 44.83' | Set 60 d Spike |
| 12" Ash | S10°W | 10.34' | Set 60 d Spike |
| 4" Elm | N16°W | 29.25' | Set 60 d Spike |
| 6" Basswood | N65°E | 7.47' | Set 60 d Spike |

Signed by *Richard C. Dunn* Date December 29, 1993
Surveyor's Michigan License No. 12020

LIBER 010 PAGE 42