

Munda

1993

RECEIVED FOR RECORD

COMMISSION

CHEBOYGAN COUNTY REMONUMENTATION CORNER

LAND CORNER RECORDATION CERTIFICATE

93 DEC 29 PM 2:35

Filing Requirement of Act 74, Mich. P.A. 1970

James Spray

CLERK/REGISTER CHEBOYGAN COUNTY, MICHIGAN

For corners in

CHEBOYGAN (County)

Located In:

Corner Code ##

- 1. Public Land Survey T 33N R 2W M-10
- 2. Property Controlling in Section S T R
- 3. Miscellaneous Property in Sec. S T R

Register of Deeds Stamp & File Number

- 4. Lot No. , Recorded Plat
- 5. Private Claims

	A	B	C	D	E	F	G	H	I	J	K	L	M
2	6	5	4	3	2	1							
3													
4	7	8	9	10	11	12							
5													
6	18	17	16	15	14	13							
7													
8	19	20	21	22	23	24							
9													
10	30	29	28	27	26	25							
11													
12	31	32	33	34	35	36							

I, Richard C. Dunn, in a field survey on November 1 - 12, 1993, do hereby certify that under requirements of P.A. 74, Michigan P.A. of 1970, the corner points mentioned in lines 1 and 2 above were in conformance with regulations and rules therefore as required in the current manual of survey instructions of the United States Department of the Interior, Bureau of Land Management or by a decree of a Court of Law and/or that the corner points mentioned in lines 3, 4 and 5 above were in conformance with the rules of the Michigan Board of Land Surveyors or by a Decree of a Court of Law; established, re-established, monumented, re-monumented, recovered, found as expressed below:

NOTE: Not more than 4 corners, all in the same town and range, may be recorded on this certificate.

A. Description of original monument and accessories and/or subsequent restoration:


G.L.O. John Mullett 1840
Set 1/4 Section Post.
Section 25 (T33N-R2W) and
Section 30 (T33N-R1W)
8" Maple N14°E.21.
8" Beech S22°W.18.

Delmer Porter #15410, 1972.
Set 4" Conc. Monument
with cap.
10" Maple N75°W.47.54'
6" Maple N80°W.44.80'
6" Maple N60°E.79.63'



B. Description of corner evidence found and/or method applied in restoring or reestablishing corner:

Found 4" Concrete Monument with cap #15410, as recorded in Book 1, Page 93, Cheboygan County L.C.R. Records.

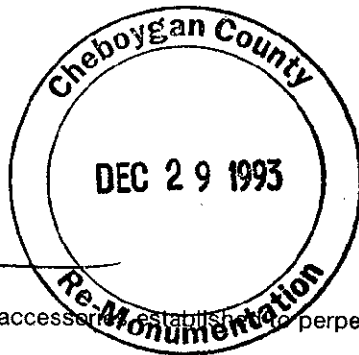

C. Description of monument for corner and accessories to establish and perpetuate locating the position of the corner:

M-10 Found 4" Concrete Monument with Cap #15410 per Book 1, Page 93, Cheboygan County Records, and replaced cap with 3" aluminum remon. cap and is accepted as a careful and faithful reestablishment of the position of the original corner.

5" Elm	N19°E	15.23'	Set 60 d Spike
12" Basswood	N46°W	25.62'	Set 60 d Spike
6" Aspen	S37°W	10'	Set 60 d Spike
6" Fir	S20°E	3.31'	Set 60 d Spike

LIBER 010 PAGE 43

Signed by: *Richard C. Dunn* Date December 29, 1993

Surveyor's Michigan License No. 12020