

1993

COMMISSION

CHEBOYGAN COUNTY REMONUMENTATION CORNER  
 LAND CORNER RECORDATION CERTIFICATE  
 Filing Requirement of Act 74, Mich. P.A. 1970

RECEIVED FOR RECORD

93 DEC 29 PM 2:36

*James Gray*  
 CLERK/REGISTER  
 CHEBOYGAN COUNTY, MICHIGAN

For corners in

CHEBOYGAN (County)	Located In:	Corner Code ##
1. Public Land Survey	T 33N R 2W	M-11
	T _____ R _____	_____
	T _____ R _____	_____
	T _____ R _____	_____
2. Property Controlling in Section	S _____ T _____ R _____	_____
	S _____ T _____ R _____	_____
3. Miscellaneous Property in Sec.	S _____ T _____ R _____	_____
	S _____ T _____ R _____	_____

Register of Deeds Stamp & File Number

4. Lot No. \_\_\_\_\_, Recorded Plat \_\_\_\_\_  
 5. Private Claims \_\_\_\_\_

	A	B	C	D	E	F	G	H	I	J	K	L	M
2	6	5	4	3	2	1							
3													
4	7	8	9	10	11	12							
5													
6	18	17	16	15	14	13							
7													
8	19	20	21	22	23	24							
9													
10	30	29	28	27	26	25							
11													
12	31	32	33	34	35	36							
13													

I, Richard C. Dunn, in a field survey on November 1 - 12, 19 93, do hereby certify that under requirements of P.A. 74, Michigan P.A. of 1970, the corner points mentioned in lines 1 and 2 above were in conformance with regulations and rules therefore as required in the current manual of survey instructions of the United States Department of the Interior, Bureau of Land Management or by a decree of a Court of Law and/or that the corner points mentioned in lines 3, 4 and 5 above were in conformance with the rules of the Michigan Board of Land Surveyors or by a Decree of a Court of Law; established, re-established, monumented, re-monumented, recovered, found as expressed below:

**NOTE: Not more than 4 corners, all in the same town and range, may be recorded on this certificate.**

A. Description of original monument and accessories and/or subsequent restoration:



G.L.O. John Mullett 1840  
 Set Post corner Sections 25 & 36 (T33N-R2W)  
 Also Sections 30 & 31 (T33N-R1W)  
 10" Maple, N29°W.10.  
 10" Maple, S16°E.12.

Delmer Porter #15410  
 L.C.R. 1973. Found 2" Pipe In Concrete Block.  
 10" Maple, N35°W.36.21'  
 6" Ironwood, S88°E.24.99'  
 7" Twin Maple, S25°W.43.73'

Thomas O'Brien #21274  
 1984. Found 2" Pipe In Conc. Mon. No witnesses.

B. Description of corner evidence found and/or method applied in restoring or reestablishing corner:

Found 2" Pipe In 8" x 8" Concrete Block, as recorded in Book 1, Page 93, Cheboygan County L.C.R. Records.

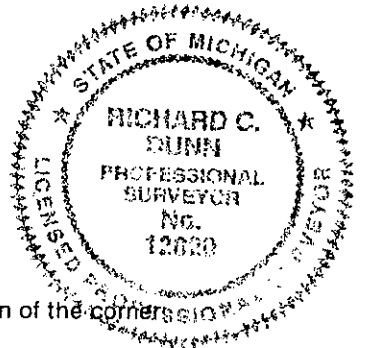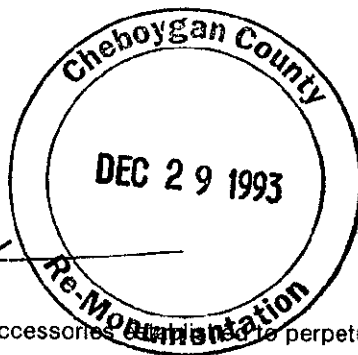

C. Description of monument for corner and accessories to perpetuate locating the position of the corner:

M-11 Found 2" Pipe In 8" x 8" Concrete Block, replaced with 5/8" x 30" Iron Bar and 3" aluminum cap per Book 1, Page 93, Cheboygan County Records, and is accepted as a careful and faithful reestablishment of the position of the original corner.

12" Maple	S86°E	10'	Set 60 d Spike
5" Fir	S27°W	21.05'	Set 60 d Spike
8" Maple	S71°W	17.66'	Set 60 d Spike
10" Tri. Elm	N37°W	21.78'	Set 60 d Spike

LIBER 010 PAGE 44

Signed by *Richard C. Dunn* Date December 29, 1993  
 Surveyor's Michigan License No. 12020