

Munday SURVEY & MAPPING

1993

COMMISSION

CHEBOYGAN COUNTY REMONUMENTATION CORNER  
LAND CORNER RECORDATION CERTIFICATE  
Filing Requirement of Act 74, Mich. P.A. 1970

RECEIVED FOR RECORD

93 DEC 29 PM 2:37

For corners in  
CHEBOYGAN  
(County)

Located In: Corner Code #

- 1. Public Land Survey T 33N R 2W Corner Code # M-12  
T \_\_\_\_\_ R \_\_\_\_\_  
T \_\_\_\_\_ R \_\_\_\_\_  
T \_\_\_\_\_ R \_\_\_\_\_
- 2. Property Controlling S \_\_\_\_\_ T \_\_\_\_\_ R \_\_\_\_\_  
in Section S \_\_\_\_\_ T \_\_\_\_\_ R \_\_\_\_\_
- 3. Miscellaneous S \_\_\_\_\_ T \_\_\_\_\_ R \_\_\_\_\_  
Property in Sec. S \_\_\_\_\_ T \_\_\_\_\_ R \_\_\_\_\_

*Jessie Gray*  
CLERK/REGISTER  
CHEBOYGAN COUNTY, MICHIGAN

Register of Deeds Stamp & File Number

- 4. Lot No. \_\_\_\_\_, Recorded Plat \_\_\_\_\_
- 5. Private Claims \_\_\_\_\_

	A	B	C	D	E	F	G	H	I	J	K	L	M
2	6	5	4	3	2	1							
3													
4	7	8	9	10	11	12							
5													
6	18	17	16	15	14	13							
7													
8	19	20	21	22	23	24							
9													
10	30	29	28	27	26	25							
11													
12	31	32	33	34	35	36							

I, Richard C. Dunn, in a field survey on November 1 - 12, 19 93, do hereby certify that under requirements of P.A. 74, Michigan P.A. of 1970, the corner points mentioned in lines 1 and 2 above were in conformance with regulations and rules therefore as required in the current manual of survey instructions of the United States Department of the Interior, Bureau of Land Management or by a decree of a Court of Law and/or that the corner points mentioned in lines 3, 4 and 5 above were in conformance with the rules of the Michigan Board of Land Surveyors or by a Decree of a Court of Law; established, re-established, monumented, re-monumented, recovered, found as expressed below:

NOTE: Not more than 4 corners, all in the same town and range, may be recorded on this certificate.

A. Description of original monument and accessories and/or subsequent restoration:


G.L.O. John Mullett 1840  
Set 1/4 Sec. Post  
Section 36 (T33N-R2W) and  
Section 31 (T33N-R1W)  
16" Pine N19°E.14.  
8" Fir S25°W.19.

Thomas O'Brien #21274  
October 12, 1984 showed  
this corner midway between  
the NE and SE corners of  
Section 36. No corner found.



B. Description of corner evidence found and/or method applied in restoring or reestablishing corner:

Established corner midway between the NE and SE corners of Section 36, T33N-R2W, November, 1993.

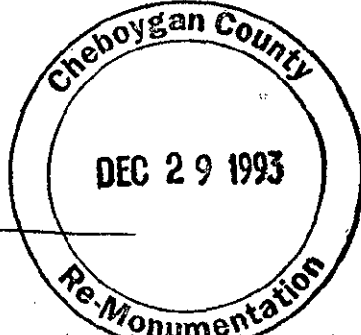

*Marvin A. Pelt*

C. Description of monument for corner and accessories established to perpetuate locating the position of the corner:

- M-12 Set 5/8" x 30" Iron Rod and 3" Remon. Cap midway between the NE and SE corners of Section 36, T33N-R2W, November, 1993, and is accepted as a careful and faithful reestablishment of the position of the original corner.
- |                |       |        |                |
|----------------|-------|--------|----------------|
| 18" Quad Maple | S49°W | 6.23'  | Set 60 d Spike |
| 10" Aspen      | S40°E | 46.24' | Set 60 d Spike |
| 8" Red Pine    | N75°E | 44.53' | Set 60 d Spike |
| 8" Red Pine    | N75°W | 49.68' | Set 60 d Spike |

LIBER 010 PAGE 45

Signed by *Richard C. Dunn*

Date December 29, 1993

Surveyor's Michigan License No. 12020