

1993

COMMISSION

CHEBOYGAN COUNTY REMONUMENTATION CORNER

LAND CORNER RECORDATION CERTIFICATE, 93 DEC 29 PH 2: 22  
Filing Requirement of Act 74, Mich. P.A. 1970

RECEIVED FOR RECORD

*Joanna Sperry*  
CLERK/REGISTER  
CHEBOYGAN COUNTY, MICHIGAN

For corners in

CHEBOYGAN  
(County)

Located In:

Corner Code #

- 1. Public Land Survey T 33N R 2W M-13  
T \_\_\_\_\_ R \_\_\_\_\_  
T \_\_\_\_\_ R \_\_\_\_\_  
T \_\_\_\_\_ R \_\_\_\_\_
- 2. Property Controlling S \_\_\_\_\_ T \_\_\_\_\_ R \_\_\_\_\_  
in Section S \_\_\_\_\_ T \_\_\_\_\_ R \_\_\_\_\_
- 3. Miscellaneous S \_\_\_\_\_ T \_\_\_\_\_ R \_\_\_\_\_  
Property in Sec. S \_\_\_\_\_ T \_\_\_\_\_ R \_\_\_\_\_

Register of Deeds Stamp & File Number

- 4. Lot No. \_\_\_\_\_, Recorded Plat \_\_\_\_\_
- 5. Private Claims \_\_\_\_\_

	A	B	C	D	E	F	G	H	I	J	K	L	M
2	6		5		4		3		2		1		
3													
4	7		8		9		10		11		12		
5													
6	18		17		16		15		14		13		
7													
8	19		20		21		22		23		24		
9													
10	30		29		28		27		26		25		
11													
12	31		32		33		34		35		36		
13													

I, Richard C. Dunn, in a field survey on November 1 - 12, 19 93, do hereby certify that under requirements of P.A. 74, Michigan P.A. of 1970, the corner points mentioned in lines 1 and 2 above were in conformance with regulations and rules therefore as required in the current manual of survey instructions of the United States Department of the Interior, Bureau of Land Management or by a decree of a Court of Law and/or that the corner points mentioned in lines 3, 4 and 5 above were in conformance with the rules of the Michigan Board of Land Surveyors or by a Decree of a Court of Law; established, re-established, monumented, re-monumented, recovered, found as expressed below:

NOTE: Not more than 4 corners, all in the same town and range, may be recorded on this certificate.


A. Description of original monument and accessories and/or subsequent restoration:

G.L.O. John Mullett 1840  
Set Post corner Townships  
T32N-R3W, T32N-R2W,  
T33N-R3W and T33N-R2W  
16" Pine, N56°E.65.  
16" Pine, N50°W.40.


Thomas O'Brien #21274  
L.C.R. October, 1984.  
Found 1/2" Iron Bar.  
12" Red Pine, N45°E.83.85'  
6" Jack Pine, S46°E.46.2'

B. Description of corner evidence found and/or method applied in restoring or reestablishing corner:

Found 1/2" Iron Bar by Thomas O'Brien, PS, as recorded in Liber 1, Page 328, Cheboygan County L.C.R. Records.

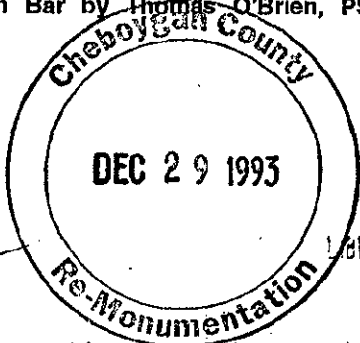

LIBER 010 PAGE 33

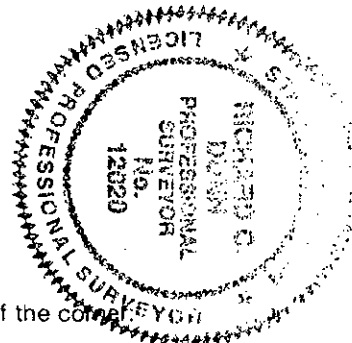

C. Description of monument for corner and accessories established to perpetuate locating the position of the corner:

M-13 Found 1/2" Iron Bar per Liber 1, Page 328, Cheboygan County Records, replaced with a 5/8" x 30" Iron Bar with 3" aluminum remonumentation cap and is accepted as a careful and faithful reestablishment of the position of the original corner.

14" Red Pine	N45°E	83.85'	Set 60 d Spike
12" Jack Pine	S47°E	46.26'	Set 60 d Spike
10" Red Pine	S78°W	21.47'	Set 60 d Spike
30" Maple	N9°W	55.12'	Set 60 d Spike

Signed by *Richard C. Dunn* Date December 29, 1993

Surveyor's Michigan License No. 12020