LAND CORNER RECORDATION CERTIFICATE

Filing Requirement of Act 74, Mich. P.A. 1970

For corners in
CHEBOYGAN
(County)

	Located In:	Corner Code ##
1. Public Land Survey	T 33N R 02W	D-10
	T ___ R ___	
	T ___ R ___	
	T ___ R ___	
2. Property Controlling	S 29 T ___ R ___	12
in Section	S ___ T ___ R ___	
3. Miscellaneous	S ___ T ___ R ___	
Property in Sec.	S ___ T ___ R ___	

Register of Deeds Stamp & File Number

4. Lot No. _____ , Recorded Plat _____
5. Private Claims _____

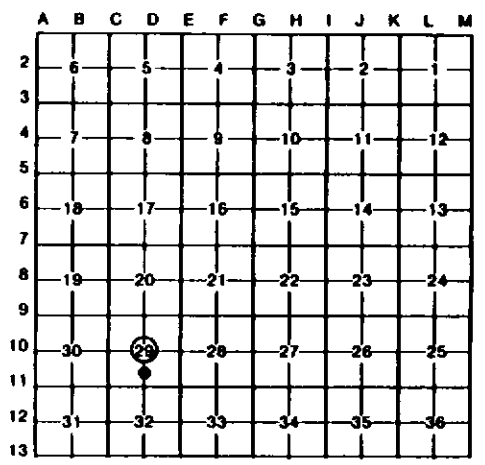

I, CARL T. KIISKILA , in a field survey on AUGUST 14 , 19 96 , do hereby certify that under requirements of P.A. 74, Michigan P.A. of 1970, the corner points mentioned in lines 1 and 2 above were in conformance with regulations and rules therefore as required in the current manual of survey instructions of the United States Department of the Interior, Bureau of Land Management or by a decree of a Court of Law and/or that the corner points mentioned in lines 3, 4 and 5 above were in conformance with the rules of the Michigan Board of Land Surveyors or by a Decree of a Court of Law; established, re-established, monumented, re-monumented, recovered, found as expressed below:

NOTE: Not more than 4 corners, all in the same town and range, may be recorded on this certificate.

A. Description of original monument and accessories and/or subsequent restoration:

D-10 12

(NO EVIDENCE OF G.L.O. CORNER, B.T'S, LINE TREES & TOPOGRAPHY, AS CALLED OUT IN THE G.L.O. LINE NOTES; UNLESS NOTED IN ITEM "B" BELOW.)

B. Description of corner evidence found and/or method applied in restoring or reestablishing corner:

D-10	12
FOUND AND ACCEPTED A 1/2" IRON BAR WITH CAP AS SET BY J.SCHWANDT, P.S. #26466, PER HIS CERTIFICATE OF SURVEY RECORDED IN LIBER 601 PAGE 383.	FOUND AND ACCEPTED A 1/2" BAR FOR THE SE COR OF THE NE1/4 OF THE SW1/4 OF SEC. 29, AS SET BY J.SCHWANDT, PS #26466. THIS POSITION FITS STANDARD BLM INSTRUCTIONS FOR SUBDIVISION OF A SECTION.

C. Description of monument for corner and accessories established to perpetuate locating the position of the corner:

D-10			12		
FD 1/2" IRON WITH CAP IN FN			FD 1/2" ROD W/CAP.		
CORNER, WIRE E & N.			FN POST	N83°W	6.46'
# ELM 7"	S84°W	16.68'	FN POST	S05°W	7.30'
#TRI.ASH 28"	S20°W	42.02'	FD 1/2" CAPPED ROD RCD #12020,		
# ASH 18"	S71°E	45.78'	RICHARD C. DUNN, N09°E		12.07'
DBL. ASH 14"	N63°E	42.12'			

STATE OF MICHIGAN
CARL KIISKILA
LAND SURVEYOR
No. 33981
LICENSED LAND SURVEYOR

= OLD WIT BY J.SCHWANDT, PS

Signed by Carl T. Kiiskila Date 3-28-97

Surveyor's Michigan License No. 33981

FORM APPROVED BY MICHIGAN STATE BOARD OF LAND SURVEYORS, JAN. 28, 1971
REVISED MAY 14, 1975
REVISED JAN., 1983