

SURVEY & REMONUMENTATION

MAY 05 1997

COMMISSION

LAND CORNER RECORDATION CERTIFICATE
Filing Requirement of Act 74, Mich. P.A. 1970

RECEIVED FOR RECORD

96 DEC -6 AM 11:22

Joanna Gray
CLERK/REGISTER
CHEBOYGAN COUNTY, MICHIGAN

For corners in Charlevoix & Cheboygan
(County)

Located In: Corner Code #

1. Public Land Survey	T33N R4W	M-8
	T33N R3W	A-8
	T___ R___	_____
	T___ R___	_____
2. Property Controlling in Section	S___ T___ R___	_____
	S___ T___ R___	_____
3. Miscellaneous Property in Sec.	S___ T___ R___	_____
	S___ T___ R___	_____

Register of Deeds Stamp & File Number

4. Lot No. _____, Recorded Plat _____
5. Private Claims _____

A	B	C	D	E	F	G	H	I	J	K	L
1											
2	6	5	4	3	2	1					
3											
4	7	8	9	10	11	12					
5											
6	18	17	16	15	14	13					
7											
8	19	20	21	22	23	24					
9											
10	30	29	28	27	26	25					
11											
12	31	32	33	34	35	36					
13											

I, James E. Evans, in a field survey on Oct. 2, 1996 do hereby state that under requirements of P.A. 74, Michigan P.A. of 1970, the corner points mentioned in lines 1 and 2 above were in conformance with regulations and rules therefore as required in the current manual of survey instructions of the United States Department of the Interior, Bureau of Land Management or by a decree of a Court of Law and/or that the corner points mentioned in lines 3, 4 and 5 above were in conformance with the rules of the Michigan Board of Land Surveyors or by a Decree of a Court of Law; established, re-established, monumented, recovered, found as expressed below:

NOTE: Not more than 2 corners, all in the same town and range, may be recorded on this certificate.

A. Description of original monument and accessories and/or subsequent restoration:

M-8 QUARTER CORNER COMMON TO SEC 24, T33N-R4W and SEC 19, T33N-R3W

GLO: Set quarter post
Sugar S31°W 29 lks (19.14')
10" Beech N 6°E 31 lks (20.46')
by John Mullett in 1840

5-19-1887
E.K. Robinson survey notes
Found Sec. corner
Same witness as GLO

June 1970 Survey by Charlevoix
Abstract & Engineering
Computed corner at mid point between Sec coners

B. Description of corner evidence found and/or method applied in restoring or reestablishing corner:

Found no evidence of GLO post or witnesses. Found 3/4" pipe 12" above ground.
Pipe is 25 ft East and 22 ft South of a split of the section corners.

Computed corner on split between M-7 and M-9 at prorated distance from Center Quarter corner as shown by 1887 E.K. Robinson survey.



Computed corner falls 4.4ft East of true line between M-7 and M-9.

GLO to M-7 = 2640'	GLO to M-9 = 2640'
CA&E 1970 = 2660.27'	CA&E 1970 = 2660.27'
Meas = 2660.35'	Meas = 2660.35'

C. Description of monument for corner and accessories established to perpetuate locating the position of the corner:
Removed old pipe and set Charlevoix County cast iron monument at computed position.

- 7" Maple N53°E 14.04' set nail & cap #22431 in SE side
- 12" Maple S55°E 35.49' set nail & cap #22431 in NE side
- 17" Maple S87°W 16.45' set nail & cap #22431 in South side
- 8" Maple N23°W 23.80' set nail & cap #22341 in East side

And is accepted as a careful and faithful reestablishment of the position of the original corner.

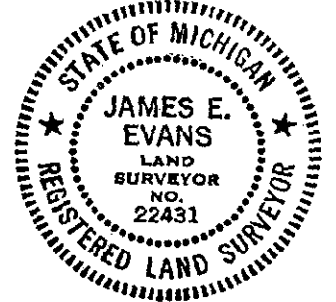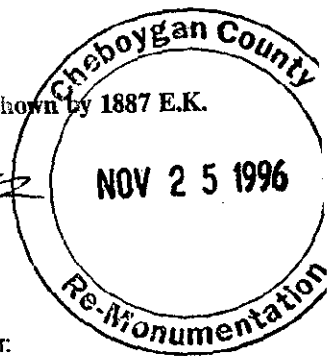

LIBER 010 PAGE 213

Signed by James E. Evans
Surveyor's Michigan License No. 22431

Date 10-10-96