

**SURVEY & REMONUMENTATION**

MAY 05 1997

COMMISSION

**LAND CORNER RECORDATION CERTIFICATE**  
Filing Requirement of Act 74, Mich. P.A. 1970

RECEIVED FOR RECORD

96 DEC -6 AM 11:26

*James Gray*  
CLERK/REGISTER  
CHEBOYGAN COUNTY, MICHIGAN

For corners in Charlevoix & Cheboygan  
(County)

Located in: Corner Code #

1. Public Land Survey	T 33N R 4W	M-12
	T 33N R 3W	A-12
	T ___ R ___	___
	T ___ R ___	___
2. Property Controlling in Section	S ___ T ___ R ___	___
	S ___ T ___ R ___	___
3. Miscellaneous Property in Sec.	S ___ T ___ R ___	___
	S ___ T ___ R ___	___

Register of Deeds Stamp & File Number

4. Lot No. \_\_\_\_\_, Recorded Plat \_\_\_\_\_  
5. Private Claims \_\_\_\_\_

	A	B	C	D	E	F	G	H	I	J	K	L
1												
2	6		5		4		3		2		1	
3												
4	7		8		9		10		11		12	
5												
6	18		17		16		15		14		13	
7												
8	19		20		21		22		23		24	
9												
10	30		29		28		27		26		25	
11												
12	31		32		33		34		35		36	
13												

I, James E. Evans, in a field survey on Oct. 2, 1996 do hereby state that under requirements of P.A. 74, Michigan P.A. of 1970, the corner points mentioned in lines 1 and 2 above were in conformance with regulations and rules therefore as required in the current manual of survey instructions of the United States Department of the Interior, Bureau of Land Management or by a decree of a Court of Law and for that the corner points mentioned in lines 3, 4 and 5 above were in conformance with the rules of the Michigan Board of Land Surveyors or by a Decree of a Court of Law; established, re-established, monumented, recovered, found as expressed below:

NOTE: Not more than 2 corners, all in the same town and range, may be recorded on this certificate.

A. Description of original monument and accessories and/or subsequent restoration:

M-12 QUARTER CORNER COMMON TO SEC 36, T33N-R4W and SEC 31, T33N-R3W

GLO: Set quarter post  
14" Hemlock S33°W 23 lks (15.18')  
10" Sugar N39°E 45 lks (29.70')  
by John Mullett in 1840

B. Description of corner evidence found and/or method applied in restoring or reestablishing corner:


Found no evidence of GLO post or witnesses. No evidence of occupation lines or previous surveys.

Computed corner by single proration distance between corners M-9 and M-13.

GLO to M-9 = 2640'  
Meas = 2643.37'

GLO to M-11 = 2640'  
Meas = 2643.37'

LIBER 010 PAGE 217

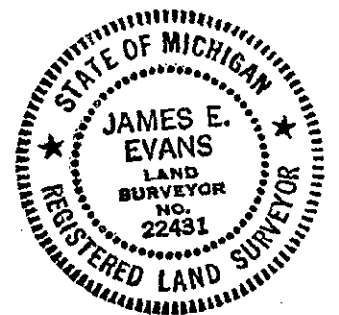

C. Description of monument for corner and accessories established to perpetuate locating the position of the corner:

Set Charlevoix County cast iron monument at computed position.  
Corner is ± 40 ft East of 2-track "Y" intersection.

16" Cherry N26°E 77.07' set nail & cap #22431 in West side  
Tw. 6" Maple N77°E 69.51' set nail & cap #22431 in SE side  
20" Cherry S23°W 83.13' set nail & cap #22431 in East side  
7" Red Pine N74°W 82.12' set nail & cap #22341 in North side

And is accepted as the best available evidence of the position of the original corner.

Signed by James E. Evans  
Surveyor's Michigan License No. 22431

Date 10-10-96

