

SURVEY & REMONUMENTATION

MAY 05 1997

COMMISSION

**RE MONUMENTATION
LAND CORNER RECORDATION CERTIFICATE
Filing Requirement of Act 74, Mich. P.A. 1970**

For corners in

<u>Cheboygan</u> (County)	Located In:	Corner Code #
1. Public Land Survey	T <u>33N</u> R <u>3W</u>	<u>M-3</u>
	T <u> </u> R <u> </u>	<u> </u>
	T <u> </u> R <u> </u>	<u> </u>
	T <u> </u> R <u> </u>	<u> </u>
2. Property Controlling In Section	S <u> </u> T <u> </u> R <u> </u>	<u> </u>
	S <u> </u> T <u> </u> R <u> </u>	<u> </u>
3. Miscellaneous Property in Sec.	S <u> </u> T <u> </u> R <u> </u>	<u> </u>
	S <u> </u> T <u> </u> R <u> </u>	<u> </u>

RECEIVED FOR RECORD
96 NOV 25 PM 12:47
James Gray
CLERK/REGISTER
CHEBOYGAN COUNTY, MICHIGAN
Register of Deeds Stamp & File Number

4. Lot No. _____, Recorded Plat _____
5. Private Claims _____

I, Brian K. Fullford, in a field survey on August, 19 96 do hereby state that under requirements of P.A. 74, Michigan P.A. of 1970, the corner points mentioned in lines 1 and 2 above were in conformance with regulations and rules therefore as required in the current manual of survey instructions of the United States Department of the Interior, Bureau of Land Management or by a decree of a Court of Law and/or that the corner points mentioned in lines 3, 4 and 5 above were in conformance with the rules of the Michigan Board of Land Surveyors or by a Decree of a Court of Law; established, re-established, monumented, recovered, found as expressed below:

NOTE: Not more than 2 corners, all in the same town and range, may be recorded on this certificate.

	A	B	C	D	E	F	G	H	I	J	K	L	M
1													
2	6		5		4		3		2		1		
3													
4	7		8		9		10		11		12		
5													
6	18		17		16		15		14		13		
7													
8	19		20		21		22		23		24		
9													
10	30		29		28		27		26		25		
11													
12	31		32		33		34		35		36		
13													

A. Description of original monument and accessories and/or subsequent restoration:

GL.O. Set Section Corner Post 14" Beech S10°W 31 Links 10" Sugar N26°E 22 Links	1960 LCRC In County Surveyor Corner Records Dean DeLamater #5778 Fnd "X" In Large Stone Set Boat Spike 15" Maple N53°E 40.04' 18" Elm N32°W 41.04' 12" Elm S55°E 46.17'	1964 LCRC Recorded Survey Liber A, Page 61 Orlando Doyle #7319 Fnd Boat Spike 3 DeLamater Witnesses	Paul Richards Hilltop Add'n To the Village of Wolverine Recorded in Liber 4, Page 3 Cheboygan County Records
--	--	---	---

B. Description of corner evidence found and/or method applied in restoring or reestablishing corner:

Fnd PK Nail on top of Boat Spike in Center Line of Asphalt Road.
Concrete Monument 33' South (Paul Richards Hilltop Addn)
27" Maple N53°E 40.04' (DeLamater Witness)




LIBER 010 PAGE 191

C. Description of monument for corner and accessories established to perpetuate locating the position of the corner:

M-3 Fnd PK Nail on top of boat spike in Center Line Asphalt Road. Replaced with 5/8" x 36" Bar with Remonumentation Cap in Monument Box. Accepted as a careful & faithful re-establishment of the position of the original corner.

Concrete Monument 33' South and 165' West Per Plat of Paul Richards Hilltop Addn
27" Maple N53°E 40.04' Set Tag
P. Pole S63°E' W/Pk
6" Tw Apple S65°W Set Tag
P. Pole N14°W 20.40' W/60p

Marvin A. Ray

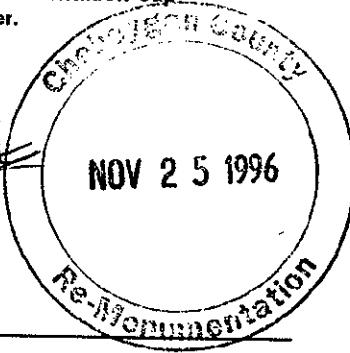

THIS CORNER IS ALSO DESIGNATED AS CORNER CODE #A-3, IN T33N-R2W.

Signed by Brian K. Fullford
Surveyor's Michigan License No. 41099
Brian K. Fullford, PS

Date 10/22/96