

**SURVEY & REMONUMENTATION**

MAY 05 1997

**COMMISSION**

**RE MONUMENTATION  
LAND CORNER RECORDATION CERTIFICATE  
Filing Requirement of Act 74, Mich. P.A. 1970**

For corners in

Cheboygan

(County)

Located In:

Corner Code #

1. Public Land Survey	T	<u>33N</u>	R	<u>3W</u>	M-4
	T		R		
	T		R		
	T		R		
2. Property Controlling in Section	S		T	R	
	S		T	R	
3. Miscellaneous Property in Sec.	S		T	R	
	S		T	R	

4. Lot No. \_\_\_\_\_, Recorded Plat \_\_\_\_\_  
5. Private Claims \_\_\_\_\_

I, Brian K. Fullford, in a field survey on August, 1996 do hereby state that under requirements of P.A. 74, Michigan P.A. of 1970, the corner points mentioned in lines 1 and 2 above were in conformance with regulations and rules therefore as required in the current manual of survey instructions of the United States Department of the Interior, Bureau of Land Management or by a decree of a Court of Law and for that the corner points mentioned in lines 3, 4 and 5 above were in conformance with the rules of the Michigan Board of Land Surveyors or by a Decree of a Court of Law; established, re-established, monumented, recovered, found as expressed below:

NOTE: Not more than 2 corners, all in the same town and range, may be recorded on this certificate.

A. Description of original monument and accessories and/or subsequent restoration:

G.L.O. Set 1/4 Corner 10" Spruce S01°W 31 Links 10" Cedar N51°W 25 Links	1923 Recorded in County Surveyor Records Survey By David Bowen Cedar Post in Center of N/S Road	1957 LCRC Liber A, Page 65 Orlando Doyle #7319 Fnd Concrete Monument 6" Cedar N51°30'E 22.32' 12" Cedar S20°E 31.75' 10" Cedar S61°30'W 53.00'
---	---	--

B. Description of corner evidence found and/or method applied in restoring or reestablishing corner:

Fnd Broken Concrete Monument  
Fnd 12" Cedar N51°30'E 22.26' (Doyle Witness)

LIBER **010** PAGE **192**




C. Description of monument for corner and accessories established to perpetuate locating the position of the corner:

M-4 Fnd Broken Concrete Monument.. Replaced with 5/8" x 36" Bar & Remon Cap 4" Below Grade in Center Line of 2 Track. Accepted as a careful & faithful re-establishment of the position of the original corner.

- 12" Cedar N51°30'E 22.26 w/60p nail
- 10" Cedar S54°E 27.16' w/60p nail
- 15" Poplar S76°W 21.19' w/60p nail
- 18" Poplar N39°W 31.07' w/60p nail

*Maurice A. Reed*

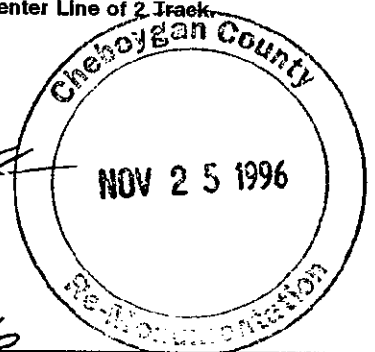

THIS CORNER IS ALSO DESIGNATED AS CORNER CODE #A-4, T33N-R2W.

Signed by *Brian K. Fullford*  
Surveyor's Michigan License No. 41099  
Brian K. Fullford, PS

Date 10/22/96

RECEIVED FOR RECORD  
96 NOV 25 PM 12:48

*James Gray*  
CLERK/REGISTER  
CHEBOYGAN COUNTY, MICHIGAN

Register of Deeds Stamp & File Number

A	B	C	D	E	F	G	H	I	J	K	L	M
1												
2	6		5		4		3		2		1	
3												
4	7		8		9		10		11		12	
5												
6	18		17		16		15		14		13	
7												
8	19		20		21		22		23		24	
9												
10	30		29		28		27		26		25	
11												
12	31		32		33		34		35		36	
13												