SURVEY &
REMONUMENTATION

MAY 0 5 1997

COMMISSION

RE MONUMENTATION
LAND CORNER RECORDATION CERTIFICATE
Filing Requirement of Act 74, Mich. P.A. 1970

RECEIVED
FOR RECORD

96 NOV 25 PM 12: 49

James Spacy
CLERK/REGISTER
CHEBOYGAN COUNTY, MICHIGAN

Register of Deeds Stamp & File Number

For corners in **Cheboygan** (County) Located In: Corner Code #

1. Public Land Survey		T 33N R 3W		M-5
		T___ R___		
		T___ R___		
		T___ R___		
2. Property Controlling	S___	T___ R___		
in Section	S___	T___ R___		
3. Miscellaneous	S___	T___ R___		
Property in Sec.	S___	T___ R___		

4. Lot No. _____ , Recorded Plat _____
5. Private Claims _____

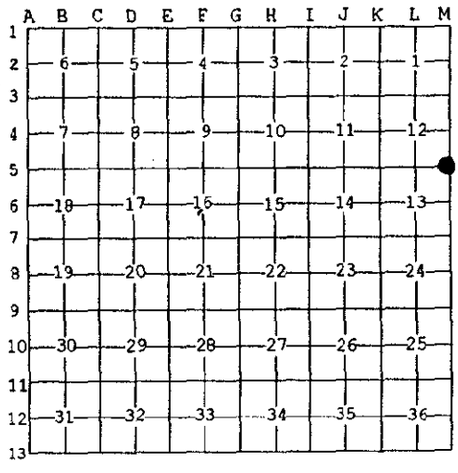

I, Brian K. Fullford, in a field survey on August, 19 96 do hereby state that under requirements of P.A. 74, Michigan P.A. of 1970, the corner points mentioned in lines 1 and 2 above were in conformance with regulations and rules therefore as required in the current manual of survey instructions of the United States Department of the Interior, Bureau of Land Management or by a decree of a Court of Law and /or that the corner points mentioned in lines 3, 4 and 5 above were in conformance with the rules of the Michigan Board of Land Surveyors or by a Decree of a Court of Law; established, re-established, monumented, recovered, found as expressed below:

NOTE: Not more than 2 corners, all in the same town and range, may be recorded on this certificate.

A. Description of original monument and accessories and/or subsequent restoration:

G.L.O.
Set Section Corner Post
16" Sugar Maple N01°W 29 Links
12" Sugar Maple S15°E 15 Links

1923 Recorded County Surveyor Records
Survey by David Bowen
Cedar Post In Center of Road With R.R.
Spike In Top

1947 LCRC
Liber A, Page 63
Orlando Doyle #7319
Fnd Wood Stake
Set Concrete Monument
6" Elm (1 of 2) S21°W 73.50'
10" Elm S89°30'W 74.65'
7" Elm (1 of 3) N16°45'E 72.75'

B. Description of corner evidence found and/or method applied in restoring or reestablishing corner:
Fnd Concrete Monument 2' West of 2-Track Centerline
- No Witnesses found
- Distance Checked Good To The North (2640' GLO, 2635.08' MEAS)

STATE OF MICHIGAN
BRIAN K. FULLFORD
PROFESSIONAL SURVEYOR
No. 41099
LICENSED PROFESSIONAL SURVEYOR

LIBER 010 PAGE 193

C. Description of monument for corner and accessories established to perpetuate locating the position of the corner:

M-5 Fnd Concrete Monument. Set Remonumentation Cap on Existing Monument. Accepted as a careful & faithful re-establishment of the position of the original corner.

2' W of Centerline 2-track
4" Elm N44°E 25.00' Set Tag
6" Willow S33°E 32.48' Set Tag
7" Poplar S36°W59.24' Set Tag
5" Elm N40°W 25.62 Set Tag
Fence Corner West 19.5'

Cheboygan County
NOV 2 5 1996
Re-Monumentation

THIS CORNER IS ALSO DESIGNATED AS CORNER CODE #A-5, IN T33N-R2W

Signed by _____ Date 10/22/96
Surveyor's Michigan License No. 41099
Brian K. Fullford, PS

FORM APPROVED BY MICHIGAN STATE BOARD OF PROFESSIONAL SURVEYORS, JAN. 28, 1971
REVISED MAY 14, 1975
REVISED JAN., 1983
REVISED OCT., 1985