

**SURVEY & REMONUMENTATION**

MAY 05 1997

COMMISSION

**RE MONUMENTATION  
LAND CORNER RECORDATION CERTIFICATE**  
Filing Requirement of Act 74, Mich. P.A. 1970

RECEIVED  
FOR RECORD  
96 NOV 25 PM 12:50  
*J. J. [Signature]*  
CLERK/REGISTER  
CHEBOYGAN COUNTY, MICHIGAN

For corners in

<u>Cheboygan</u> (County)	Located In:	Corner Code #
1. Public Land Survey	T <u>33N</u> R <u>3W</u>	<u>M-6</u>
2. Property Controlling in Section	T <u>    </u> R <u>    </u>	<u>    </u>
3. Miscellaneous Property in Sec.	T <u>    </u> R <u>    </u>	<u>    </u>
	S <u>    </u> T <u>    </u> R <u>    </u>	<u>    </u>
	S <u>    </u> T <u>    </u> R <u>    </u>	<u>    </u>
	S <u>    </u> T <u>    </u> R <u>    </u>	<u>    </u>
	S <u>    </u> T <u>    </u> R <u>    </u>	<u>    </u>
4. Lot No. <u>    </u> , Recorded Plat <u>    </u>		
5. Private Claims <u>    </u>		

Register of Deeds Stamp & File Number

I, Brian K. Fullford, in a field survey on August, 19 96 do hereby state that under requirements of P.A. 74, Michigan P.A. of 1970, the corner points mentioned in lines 1 and 2 above were in conformance with regulations and rules therefore as required in the current manual of survey instructions of the United States Department of the Interior, Bureau of Land Management or by a decree of a Court of Law and /or that the corner points mentioned in lines 3, 4 and 5 above were in conformance with the rules of the Michigan Board of Land Surveyors or by a Decree of a Court of Law; established, re-established, monumented, recovered, found as expressed below:

NOTE: Not more than 2 corners, all in the same town and range, may be recorded on this certificate.

A	B	C	D	E	F	G	H	I	J	K	L	M
1												
2	6	5	4	3	2	1						
3												
4	7	8	9	10	11	12						
5												
6	18	17	16	15	14	13						
7												
8	19	20	21	22	23	24						
9												
10	30	29	28	27	26	25						
11												
12	31	32	33	34	35	36						
13												

- A. Description of original monument and accessories and/or subsequent restoration:
- |   |  |  |
|---|--|--|
| G.L.O.<br>Set 1/4 Section Post<br>12" Sugar Maple S06°W 23 Links<br>10" Sugar Maple N34°E 5 Links | 1947 LCRC<br>Liber A, Page 63<br>Orlando Doyle #7319<br>Fnd Iron Marked Post<br>Set Concrete Mon.<br>8" Elm N85°E 17.51'<br>8" Elm N16°E 30.56'<br>9" Elm S27°E 27.20' | 1954 LCRC<br>County Surveyor Corner Records<br>Orlando Doyle #7319<br>Fnd Concrete Mon.<br>1" Pipe S62°W On N & S Fence<br>Line 17.8' South of Conc. Mon. F.P.<br>8" Elm S68° 30'E 56.50'<br>6" Elm N60°E 83.88' |
|---|--|--|

1976 Unrecorded Survey  
R.C. Dunn #12020  
Fnd Concrete Mon.  
Iron Set 33' East

- B. Description of corner evidence found and/or method applied in restoring or reestablishing corner:
- Concrete Monument on New E & W Fence
  - Fnd 5/8" Bar 33' East
  - Fnd Old Fence Line to South at 33' West
  - Fnd 1" Pipe S62°W 37.3', on old N & S Fence Line




LIBER 010 PAGE 194

- C. Description of monument for corner and accessories established to perpetuate locating the position of the corner:
- M-6 Fnd Concrete Monument. Set Remonumentation Cap on Existing Monument. Accepted as a careful & faithful re-establishment of the position of the original corner.

- 5/8" Bar East 33°
- 7" Poplar N42°E 23.59' Set Tag
- Fence Post East 13.80' Set Tag
- Fence Post West 23.08' Set Tag
- 18" Basswood N54°W 61.00' Fnd 60p nail
- 1" Pipe S62°W 37.30'

*Monica A. [Signature]*

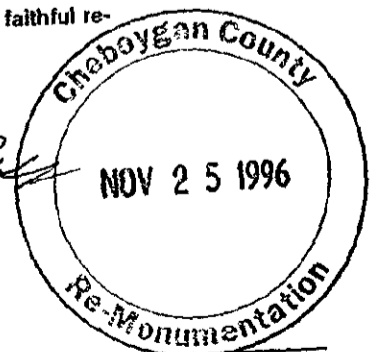

THIS CORNER IS ALSO DESIGNATED AS CORNER CODE #A-6, IN T33N-R2W

Signed by Brian K. Fullford  
Surveyor's Michigan License No. 41099  
Brian K. Fullford, PS

Date 10/22/96