

**SURVEY &  
REMONUMENTATION**

MAY 05 1997

**RE MONUMENTATION  
LAND CORNER RECORDATION CERTIFICATE  
Filing Requirement of Act 74, Mich. P.A. 1970**

For corners in **COMMISSION**

Cheboygan  
(County)

Located In:

Corner Code #

1. Public Land Survey

T 33N R 3W

M-7

T \_\_\_\_\_ R \_\_\_\_\_

T \_\_\_\_\_ R \_\_\_\_\_

T \_\_\_\_\_ R \_\_\_\_\_

T \_\_\_\_\_ R \_\_\_\_\_

2. Property Controlling  
in Section

S \_\_\_\_\_

T \_\_\_\_\_ R \_\_\_\_\_

S \_\_\_\_\_

T \_\_\_\_\_ R \_\_\_\_\_

3. Miscellaneous  
Property in Sec.

S \_\_\_\_\_

T \_\_\_\_\_ R \_\_\_\_\_

S \_\_\_\_\_

T \_\_\_\_\_ R \_\_\_\_\_

4. Lot No. \_\_\_\_\_, Recorded Plat \_\_\_\_\_  
5. Private Claims \_\_\_\_\_

I, Brian K. Fullford, in a field survey on August, 1996 do hereby state that under requirements of P.A. 74, Michigan P.A. of 1970, the corner points mentioned in lines 1 and 2 above were in conformance with regulations and rules therefore as required in the current manual of survey instructions of the United States Department of the Interior, Bureau of Land Management or by a decree of a Court of Law and /or that the corner points mentioned in lines 3, 4 and 5 above were in conformance with the rules of the Michigan Board of Land Surveyors or by a Decree of a Court of Law; established, re-established, monumented, recovered, found as expressed below:

NOTE: Not more than 2 corners, all in the same town and range, may be recorded on this certificate.

A. Description of original monument and accessories and/or subsequent restoration:

G.L.O.	1947 LCRC	1983 Unrecorded Survey
Set Section Corner Post	Liber A, Page 63	By R.C. Dunn #12020
16" Elm S87°W 13 Links	By Orlando Doyle #7319	Fnd Iron
12" Sugar Maple N89°E 5 Links	Fnd 3/4" Pipe in Conc Mon.	Corner Identified as NW Corner,
	10" Beech N55°W 26.35'	Sec 19, T33N-R2W
	6" Basswood N05°E 42.40'	

B. Description of corner evidence found and/or method applied in restoring or reestablishing corner:

Fnd 1" Pipe With 4" x 4" x 6" Concrete Monument With 3/4" Pipe Laying Next to Pipe  
12" Basswood N05°E 42.62 (Doyle Witness)  
18" Beech N59°W 26.73 (Doyle Witness)

A	B	C	D	E	F	G	H	I	J	K	L	M
1												
2	6	5	4	3	2	1						
3												
4	7	8	9	10	11	12						
5												
6	10	17	16	15	14	13						
7												
8	19	20	21	22	23	24						
9												
10	30	29	28	27	26	25						
11												
12	31	32	33	34	35	36						
13												

Register of Deeds Stamp & File Number

RECEIVED  
FOR RECORD

96 NOV 25 PM 12:51

*Jasmine Agency*  
CLERK/REGISTER  
CHEBOYGAN COUNTY, MICHIGAN


LIBER 010 PAGE 195



C. Description of monument for corner and accessories established to perpetuate locating the position of the corner:  
M-7 Fnd 1" Pipe With 4" x 4" x 6" Concrete Monument With 3/4" Pipe Laying Next to Pipe  
Replaced 1" Pipe with 5/8" x 36" Bar & Remon Cap. Accepted as a careful & faithful re-establishment of the position of the original corner.

12" Basswood N05°E 42.62' Set Tag  
Fence Corner N78°E 28.69' Set Tag  
11" Maple S72°E 25.40' Set Tag  
13" Basswood S49°W 34.78' Set Tag  
18" Beech N59°W 26.73 Set Tag  
E/W Fence Line 5.8' North  
N/S Fence Line 28' East

*Marvin A. Rose*

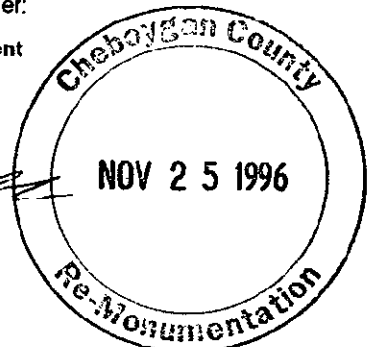

THIS CORNER IS ALSO DESIGNATED AS CORNER CODE #A-7, IN T33N-R2W.

Signed by Brian K. Fullford  
Surveyor's Michigan License No. 41099  
Brian K. Fullford, PS

Date 10/22/96