

**SURVEY &  
REMONUMENTATION**

MAY 05 1997

**RE MONUMENTATION  
LAND CORNER RECORDATION CERTIFICATE  
Filing Requirement of Act 74, Mich. P.A. 1970**

For corners in **COMMISSION**

<u>Cheboygan</u> (County)	Located In:	Corner Code #
1. Public Land Survey	T <u>33N</u> R <u>3W</u>	<u>M-9</u>
	T _____ R _____	_____
	T _____ R _____	_____
	T _____ R _____	_____
2. Property Controlling in Section	S _____ T _____ R _____	_____
	S _____ T _____ R _____	_____
3. Miscellaneous Property in Sec.	S _____ T _____ R _____	_____
	S _____ T _____ R _____	_____

RECEIVED  
FOR RECORD

96 NOV 25 PM 12: 53

*James Gray*  
CLERK/REGISTER  
CHEBOYGAN COUNTY, MICHIGAN

Register of Deeds Stamp & File Number

4. Lot No. \_\_\_\_\_, Recorded Plat \_\_\_\_\_  
5. Private Claims \_\_\_\_\_

I, Brian K. Fullford, in a field survey on August, 19 96 do hereby state that under requirements of P.A. 74, Michigan P.A. of 1970, the corner points mentioned in lines 1 and 2 above were in conformance with regulations and rules therefore as required in the current manual of survey instructions of the United States Department of the Interior, Bureau of Land Management or by a decree of a Court of Law and /or that the corner points mentioned in lines 3, 4 and 5 above were in conformance with the rules of the Michigan Board of Land Surveyors or by a Decree of a Court of Law; established, re-established, monumented, recovered, found as expressed below:

NOTE: Not more than 2 corners, all in the same town and range, may be recorded on this certificate.

	A	B	C	D	E	F	G	H	I	J	K	L	M
1													
2	6		5		4		3		2		1		
3													
4	7		8		9		10		11		12		
5													
6	18		17		16		15		14		13		
7													
8	19		20		21		22		23		24		
9													
10	30		29		28		27		26		25		
11													
12	31		32		33		34		35		36		
13													

A. Description of original monument and accessories and/or subsequent restoration:  
G.L.O. 1983 Unrecorded Survey  
Set Section Corner Post R.C. Dunn #12020  
14" Sugar Maple S31°E 27 Links Identified SW Corner Sec 12, T33N-R2W  
10" Sugar Maple N40°W 16 Links

B. Description of corner evidence found and/or method applied in restoring or reestablishing corner:  
Fnd 1/2" Pipe at Intersection of New Fence North & East  
Single Wire Fence to South  
Ancient Fence Running, (rotted posts moss covered & wire) running East & South  
Falls in Centerline of existing N & S 2-track 168' North



LIBER 010 PAGE 197


C. Description of monument for corner and accessories established to perpetuate locating the position of the corner:

M-9 Replace 1/2" Pipe with 5/8" x 36" Rebar & Remonumentation Cap. Accepted as a careful & faithful re-establishment of the position of the original corner.

4" TW. Ironwood S79°E 11.37' w/ tag  
4" TW. Maple S28°W 10.65' w/ tag  
6" Basswood S79°W 11.16' w/tag  
4" Beech N23°W 15.78' w/tag  
At intersection of North & East fence lines

THIS CORNER IS ALSO DESIGNATED AS CORNER CODE #A-9, IN T33N-R2W.

Signed by Brian K. Fullford  
Surveyor's Michigan License No. 41099  
Brian K. Fullford, PS

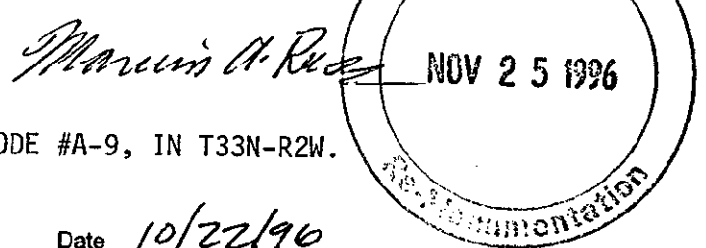

Date 10/22/96