

SURVEY & REMONUMENTATION

MAY 05 1997

For corners in **COMMISSION**

**RE MONUMENTATION
LAND CORNER RECORDATION CERTIFICATE**
Filing Requirement of Act 74, Mich. P.A. 1970

RECEIVED FOR RECORD

96 NOV 25 PM 12:55

James Gray
CLERK/REGISTER
CHEBOYGAN COUNTY, MICHIGAN

Cheboygan (County)	Located In:	Corner Code #
1. Public Land Survey	T <u>33N</u> R <u>3W</u>	M-11
	T <u> </u> R <u> </u>	_____
	T <u> </u> R <u> </u>	_____
	T <u> </u> R <u> </u>	_____
	T <u> </u> R <u> </u>	_____
2. Property Controlling in Section	S <u> </u> T <u> </u> R <u> </u>	_____
	S <u> </u> T <u> </u> R <u> </u>	_____
3. Miscellaneous Property in Sec.	S <u> </u> T <u> </u> R <u> </u>	_____
	S <u> </u> T <u> </u> R <u> </u>	_____

Register of Deeds Stamp & File Number

- 4. Lot No. _____, Recorded Plat _____
- 5. Private Claims _____

I, Brian K. Fullford, in a field survey on August, 19 96 do hereby state that under requirements of P.A. 74, Michigan P.A. of 1970, the corner points mentioned in lines 1 and 2 above were in conformance with regulations and rules therefore as required in the current manual of survey instructions of the United States Department of the Interior, Bureau of Land Management or by a decree of a Court of Law and/or that the corner points mentioned in lines 3, 4 and 5 above were in conformance with the rules of the Michigan Board of Land Surveyors or by a Decree of a Court of Law; established, re-established, monumented, recovered, found as expressed below:

NOTE: Not more than 2 corners, all in the same town and range, may be recorded on this certificate.

	A	B	C	D	E	F	G	H	I	J	K	L	M
1													
2	6		5		4		3		2		1		
3													
4	7		8		9		10		11		12		
5													
6	16		17		16		15		14		13		
7													
8	19		20		21		22		23		24		
9													
10	30		29		28		27		26		25		
11													
12	31		32		33		34		35		36		
13													

- A. Description of original monument and accessories and/or subsequent restoration:
- G.L.O. 1960 LCRC
 - Set Section Corner Post County Surveyors Corner Record
 - 16" Hemlock S66°E 11 Links Dean DeLamater #5778
 - 12" Hemlock N62°W 12 Links Fnd 1 1/2" Flat Iron
 - 7" Poplar N28°E 9.47'
 - 7" Poplar S77°W 15.95'
 - 8" Poplar S54°W 29.00'

- B. Description of corner evidence found and/or method applied in restoring or reestablishing corner:
- Fnd 1 1/2" Flat Iron
 - 7" Poplar N28°E 9.47' (Fnd-Dead)
 - 8" Poplar S54°W 29.00' (Fnd-Dead)




LIBER 010 PAGE 199

- C. Description of monument for corner and accessories established to perpetuate locating the position of the corner:

M-11 Fnd 1 1/2" Flat Iron, Replaced with 5/8" x 36" Bar & Remonumentation Cap. Accepted as a careful & faithful re-establishment of the position of the original corner.

- 8" Poplar N11°E 8.23' Set Tag
- 10" Poplar N76°E 13.52' Set Tag
- 14" Poplar N66°W 42.02' Set Tag
- 10" Poplar S02°W 25.14' Set Tag
- Between N & S Bound 1-75 400' South of Mile Marker #296

Morris A. Ross

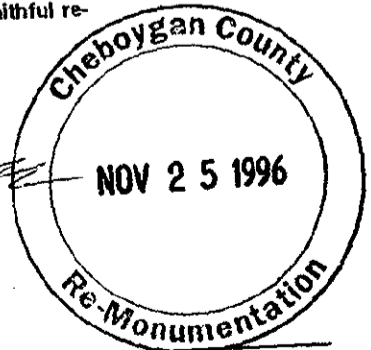

THIS CORNER IS ALSO DESIGNATED AS CORNER CODE #A-11, IN T33N-R2W.

Signed by Brian K. Fullford
Surveyor's Michigan License No. 41099

Date 10/22/96

Brian K. Fullford, PS