

**SURVEY & REMONUMENTATION**

MAY 05 1997

**RE-MONUMENTATION  
LAND CORNER RECORDATION CERTIFICATE  
Filing Requirement of Act 74, Mich. P.A. 1970**

For corners in **COMMISSION**

Cheboygan

(County)

Located In:

Corner Code #

1. Public Land Survey

T 33N R 3W

M-13

T \_\_\_ R \_\_\_

T \_\_\_ R \_\_\_

T \_\_\_ R \_\_\_

2. Property Controlling in Section

S \_\_\_ T \_\_\_ R \_\_\_

S \_\_\_ T \_\_\_ R \_\_\_

3. Miscellaneous Property in Sec.

S \_\_\_ T \_\_\_ R \_\_\_

S \_\_\_ T \_\_\_ R \_\_\_

RECEIVED FOR RECORD

96 NOV 25 PM 12: 58

*Joanna [Signature]*  
CLERK/REGISTER  
CHEBOYGAN COUNTY, MICHIGAN

Register of Deeds Stamp & File Number

4. Lot No. \_\_\_\_\_, Recorded Plat \_\_\_\_\_

5. Private Claims \_\_\_\_\_

I, Brian K. Fullford, in a field survey on August, 19 96 do hereby state that under requirements of P.A. 74, Michigan P.A. of 1970, the corner points mentioned in lines 1 and 2 above were in conformance with regulations and rules therefore as required in the current manual of survey instructions of the United States Department of the Interior, Bureau of Land Management or by a decree of a Court of Law and /or that the corner points mentioned in lines 3, 4 and 5 above were in conformance with the rules of the Michigan Board of Land Surveyors or by a Decree of a Court of Law; established, re-established, monumented, recovered, found as expressed below:

1	A	B	C	D	E	F	G	H	I	J	K	L	M
2		6		5		4		3		2		1	
3													
4		7		8		9		10		11		12	
5													
6		18		17		16		15		14		13	
7													
8		19		20		21		22		23		24	
9													
10		30		29		28		27		26		25	
11													
12		31		32		33		34		35		36	
13													

NOTE: Not more than 2 corners, all in the same town and range, may be recorded on this certificate.

A. Description of original monument and accessories and/or subsequent restoration:

- G.L.O. 1960 LCRC
- Set Section Corner Post Liber A, Page 68
- 16" Pine N02°W 38 Links Dean DeLamater #5778
- 16" Pine S15°E 50 Links Fnd 1/2" Rod in Concrete
- 5" Fir N12°E 19.65'
- 7" Fir S11°E 5.25'
- 11" Cedar N80°E 30.40'

B. Description of corner evidence found and/or method applied in restoring or reestablishing corner:

- Fnd 3 Squared off Cedar Stakes in 6" diam. Circle
- Fnd 15" Cedar N86°E 31.00' W/DeLamater Tag
- Fnd 8" Fir Stump South 5.95'
- Fnd 6" Dead Fir N40°W 1.25' W/DeLamater Tag
- Distance Checks good with existing monumentation 1/2 mile and 1 Mile North




LIBER 010 PAGE 201

C. Description of monument for corner and accessories established to perpetuate locating the position of the corner:

M-13 Set 5/8" x 36" Rebar with Remonumentation Cap in Center of 3 Cedar Stakes. Accepted as a careful & faithful re-establishment of the position of the original corner.

- 15" Poplar N58°E 11.32'
- 15" Poplar S24°E 40.00'
- 9" Spruce S31°W 32.25'
- 15" Poplar N48°W 39.87'

*Martin A. [Signature]*

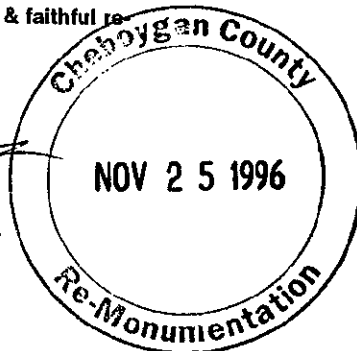

THIS CORNER IS ALSO DESIGNATED AS CORNER CODES #A-13, IN T33N-R2W, #A-1, IN T32N-R2W, AND #M-1, IN T32N-R3W.

Signed by Brian K. Fullford  
Surveyor's Michigan License No. 41099

Date 10/22/96

Brian K. Fullford, PS