

**SURVEY & REMONUMENTATION**

MAY 10 1997

**COMMISSION**

**RE MONUMENTATION  
LAND CORNER RECORDATION CERTIFICATE  
Filing Requirement of Act 74, Mich. P.A. 1970**

RECEIVED FOR RECORD

96 NOV 25 PM 1:04

*Josanna Gray*  
CLERK/REGISTER  
CHEBOYGAN COUNTY, MICHIGAN

**Cheboygan** Located In: Corner Code #  
(County)

1. Public Land Survey T 34N R 1W M-4  
T     R      
T 34 R 1E A-04  
T     R    

2. Property Controlling in Section S     T     R      
S     T     R    

3. Miscellaneous S     T     R      
Property in Sec. S     T     R    

Register of Deeds Stamp & File Number

4. Lot No. \_\_\_\_\_, Recorded Plat \_\_\_\_\_  
5. Private Claims \_\_\_\_\_

	A	B	C	D	E	F	G	H	I	J	K	L	M
1													
2	6		5		4		3		2		1		
3													
4	7		8		9		10		11		12		
5													
6	10		17		16		15		14		13		
7													
8	19		20		21		22		23		24		
9													
10	30		29		28		27		26		25		
11													
12	31		32		33		34		35		36		
13													

I, Brian K. Fullford, in a field survey on August, 1996 do hereby state that under requirements of P.A. 74, Michigan P.A. of 1970, the corner points mentioned in lines 1 and 2 above were in conformance with regulations and rules therefore as required in the current manual of survey instructions of the United States Department of the Interior, Bureau of Land Management or by a decree of a Court of Law and/or that the corner points mentioned in lines 3, 4 and 5 above were in conformance with the rules of the Michigan Board of Land Surveyors or by a Decree of a Court of Law; established, re-established, monumented, recovered, found as expressed below:

NOTE: Not more than 2 corners, all in the same town and range, may be recorded on this certificate.

A. Description of original monument and accessories and/or subsequent restoration:  
G.L.O. 1966 D.O.C. Corner Record  
Set 1/4 Section Post Kenneth Ostling #10068  
8" Spruce S44°E 8 Links Set 1" Pipe w/4" Aluminum Cap  
7" Hemlock S42°W 9 Links By Proportionate Measure  
16" Spruce N69°W 44.2'  
9" Balsam N19°E 26.0'

B. Description of corner evidence found and/or method applied in restoring or reestablishing corner:  
Fnd 1" Pipe w/4" Department of Conservation Brass Cap




LIBER 010 PAGE 206

C. Description of monument for corner and accessories established to perpetuate locating the position of the corner:

M-4 Fnd 1" Pipe with 4" Department of Conservation Brass Cap. Accepted as a careful & faithful re-establishment of the position of the original corner.

3" Balsam N80°E 5.60' Set Tag  
4" Balsam S35°E 7.12' Set Tag  
6" Balsam S67°W 6.60' Set Tag  
6" Balsam N46°W 4.24' Set Tag  
200' +/- South of Milligan Creek

*Maurice O. Rust*

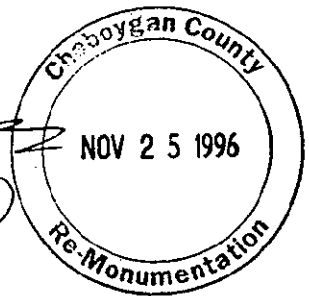

THIS CORNER IS ALSO DESIGNATED AS CORNER CODE #A-4, IN T34N-R1E.

Signed by Brian K. Fullford Date 10/22/96  
Surveyor's Michigan License No. 41099  
Brian K. Fullford, PS