

SURVEY & REMONUMENTATION

MAY 05 1997

**RE MONUMENTATION
LAND CORNER RECORDATION CERTIFICATE
Filing Requirement of Act 74, Mich. P.A. 1970**

RECEIVED FOR RECORD

96 NOV 25 PM 1:10

COMMISSION

For corners in

<u>Cheboygan</u> (County)	Located In:	Corner Code #
1. Public Land Survey	T <u>34N</u> R <u>1W</u>	M-9
	T <u>34</u> R <u>1E</u>	<u>A-09</u>
2. Property Controlling in Section	S <u> </u> T <u> </u> R <u> </u>	<u> </u>
3. Miscellaneous Property in Sec.	S <u> </u> T <u> </u> R <u> </u>	<u> </u>

James Gray
CLERK/REGISTER
CHEBOYGAN COUNTY, MICHIGAN

Register of Deeds Stamp & File Number

4. Lot No. _____, Recorded Plat _____
5. Private Claims _____

A	B	C	D	E	F	G	H	I	J	K	L	M
1												
2	6	5	4	3	2	1						
3												
4	7	8	9	10	11	12						
5												
6	10	17	16	15	14	13						
7												
8	19	20	21	22	23	24						
9												
10	30	29	28	27	26	25						
11												
12	31	32	33	34	35	36						
13												

I, Brian K. Fullford in a field survey on August, 19 96 do hereby state that under requirements of P.A. 74, Michigan P.A. of 1970, the corner points mentioned in lines 1 and 2 above were in conformance with regulations and rules therefore as required in the current manual of survey instructions of the United States Department of the Interior, Bureau of Land Management or by a decree of a Court of Law and/or that the corner points mentioned in lines 3, 4 and 5 above were in conformance with the rules of the Michigan Board of Land Surveyors or by a Decree of a Court of Law, established, re-established, monumented, recovered, found as expressed below:

NOTE: Not more than 2 corners, all in the same town and range, may be recorded on this certificate.

- A. Description of original monument and accessories and/or subsequent restoration:
- | | |
|--------------------------|--|
| G.L.O. | 1951 D.O.C. Corner Record |
| Set Section Corner Post | Dean DeLamater #5778 |
| 17" Cedar S36°E 16 Links | Set 1" Pipe w/Dept. Of Conservation 4" Brass Cap |
| 12" Cedar N46°W 11 Links | at Perpetuated Position |
| | 6" Cedar S61°R 17 Links |
| | 6" Spruce N66°W 8 Links |

- B. Description of corner evidence found and/or method applied in restoring or reestablishing corner:
- Fnd 1" Pipe w/Dept. Of Conservation 4" Brass Cap
9" Cedar S65°E 11.53' (DeLamater Witness)



LIBER 010 PAGE 211


- C. Description of monument for corner and accessories established to perpetuate locating the position of the corner:

M-9 Fnd 1" Pipe w/Dept. Of Conservation 4" Brass Cap. Accepted as a careful & faithful re-establishment of the position of the original corner.

8" Fir N82°E 6.97' Set Tag
9" Cedar S65°E 11.53' Set Tag
9" Cedar S06°W 12.75' Set Tag
9" Cedar N29°W 6.45' Set Tag

THIS CORNER IS ALSO DESIGNATED AS CORNER CODE #A-9, IN T34N-R1E.

Maurice D. Ray

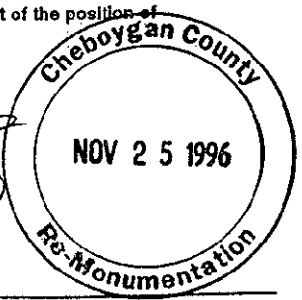

Signed by Brian K. Fullford
Surveyor's Michigan License No. 41099

Date 10/22/96

Brian K Fullford, PS