

RECEIVED FOR RECORD

99 DEC 27 PM 4: 14

LAND CORNER RECORDATION CERTIFICATE  
Filing Requirement of Act 74, Mich. P.A. 1970

*Deity Pyzyrski*  
CLERK/REGISTER  
CHEBOYGAN COUNTY MICHIGAN

For corners in

Cheboygan (County)	Located In:	Corner Code #
1. Public Land Survey	T34NR 1E	B-5
	T R	
	T R	
	T R	
2. Property Controlling in Section	S T R	
	S T R	
3. Miscellaneous Property in Sec.	S T R	
	S T R	


MAR 03 2000

SECTION  
Register of Deeds Stamp & File Number

4. Lot No. \_\_\_\_\_, Recorded Plat \_\_\_\_\_  
5. Private Claims \_\_\_\_\_

Ronald Bischer, in a field survey on Aug. 12, 1999 do hereby state that under requirements of P.A. 74, Michigan P.A. of 1970, the corner points mentioned in lines 1 and 2 above were in conformance with regulations and rules therefore as required in the current manual of survey instructions of the United States Department of the Interior, Bureau of Land Management or by a decree of a Court of Law and/or that the corner points mentioned in lines 3, 4 and 5 above were in conformance with the rules of the Michigan Board of Land Surveyors or by a Decree of a Court of Law; established, re-established, monumented, recovered, found as expressed below:

NOTE: Not more than 2 corners, all in the same town and range, may be recorded on this certificate.

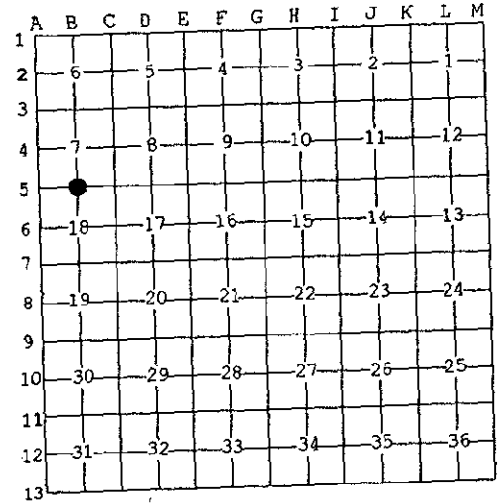

A. Description of original monument and accessories and/or subsequent restoration:

B-5  
1855 GLO Notes Resurvey  
N23°W 7 lks 12" Cedar  
S04°W 12½ lks 14" Cedar

April 15, 1988 Ronald Bischer #22428

Set ½" rod from bearing tree

N06°E 20.90' 7" Bam

S50°E 11.85' 5" Balsam S55°W 28.30' 5" Maple

B. Description of corner evidence found and/or method applied in restoring or reestablishing corner:

B-5

Aug. 12, 1999 Cheboygan County Remonumentation

Ronald Bischer #22428

found ½" rod replaced with 5/8" rod and cap #22428

found 3 witnesses



C. Description of monument for corner and accessories established to perpetuate locating the position of the corner:

B-5

5/8" rod and cap #22428


S51°W 43.96' 4" Balsam

N81°W 59.77' 12" Maple

S41°E 11.85' 5" Balsam

S76°E 59.23' 6" Maple

LIBER 011 PAGE 171

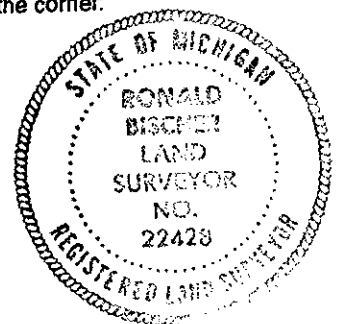

Signed by Ronald R. Bischer  
Surveyor's Michigan License No. 22428

Date 12-18-99