

LAND CORNER RECORDATION CERTIFICATE
Filing Requirement of Act 74, Mich. P.A. 1970

SECTION

For corners in

Cheboygan
(County)
Forest Township
1. Public Land Survey

Located In:	Corner Code #
T34N R 1E	C-2
T___ R___	_____
T___ R___	_____
T___ R___	_____
S___ T___ R___	_____
S___ T___ R___	_____
S___ T___ R___	_____
S___ T___ R___	_____

RECEIVED FOR RECORD 12-7-98
at 9:30 O'Clock A M

Joanne Spray

CLERK/REGISTER
CHEBOYGAN COUNTY, MICHIGAN

Register of Deeds Stamp & File Number

4. Lot No. _____, Recorded Plat _____
5. Private Claims _____

I, Ronald Bischer, in a field survey on 7-13, 1998 do hereby state that under requirements of P.A. 74, Michigan P.A. of 1970, the corner points mentioned in lines 1 and 2 above were in conformance with regulations and rules therefore as required in the current manual of survey instructions of the United States Department of the Interior, Bureau of Land Management or by a decree of a Court of Law and /or that the corner points mentioned in lines 3, 4 and 5 above were in conformance with the rules of the Michigan Board of Land Surveyors or by a Decree of a Court of Law, established, re-established, monumented, recovered, found as expressed below:

NOTE: Not more than 2 corners, all in the same town and range, may be recorded on this certificate.

	A	B	C	D	E	F	G	H	I	J	K	L	M
1													
2	6		5		4		3		2		1		
3													
4	7		8		9		10		11		12		
5													
6	18		17		16		15		14		13		
7													
8	19		20		21		22		23		24		
9													
10	30		29		28		27		26		25		
11													
12	31		32		33		34		35		36		
13													

A. Description of original monument and accessories and/or subsequent restoration:


C-2
1855 GLO notes by George Cannon
(resurvey) set wood post
N33°E 32 1ks 8" Beech
N57°W 35.51ks 12" Sugar

Sept. 13, 1972 Delmer Porter #15410
found 1/2" rod and cap
found 4 witnesses

June 7, 1972 Delmer Porter #15410
set 1/2" rod and cap from fence corner
set 4 witnesses


B. Description of corner evidence found and/or method applied in restoring or reestablishing corner:

C-2
Found 1/2" rod and cap
replaced with 5/8" rod and remon cap

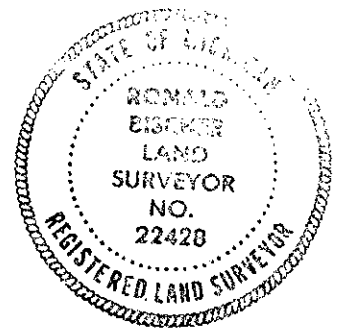

C. Description of monument for corner and accessories established to perpetuate locating the position of the corner:

C-2
5/8" Rod and Remon cap
S34°E 41.33' 5" Elm
S78°E 33.84' Fence Corner O.W.
N83°W 41.37' Fence Corner O.W.
N57°W 37.39' P. Pole O.W.

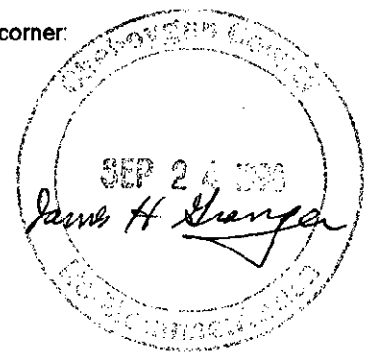

LIBER 011 PAGE 95

Signed by Ronald R. Bischer
Surveyor's Michigan License No. 22428

Date Sept. 28, 1998