

MAR 2 1999

CHEBOYGAN COUNTY, STATE OF MICHIGAN REMONUMENTATION

SECTION

LAND CORNER RECORDATION CERTIFICATE
Filing Requirement of Act 74, Mich. P.A. 1970

For corners in

<u>Cheboygan</u> (County)	Located In:	Corner Code #
Forest Township	<u>T34N R 1E</u>	<u>C-3</u>
1. Public Land Survey	T___ R___	___
	T___ R___	___
	T___ R___	___
2. Property Controlling in Section	S___ T___ R___	___
	S___ T___ R___	___
3. Miscellaneous Property in Sec.	S___ T___ R___	___
	S___ T___ R___	___

RECEIVED FOR RECORD 12-7-98
at 9:31 O'Clock A M

James H. Thayer

CLERK/REGISTER
CHEBOYGAN COUNTY, MICHIGAN

Register of Deeds Stamp & File Number

4. Lot No. _____, Recorded Plat _____
5. Private Claims _____

I, Ronald Bischer, in a field survey on 7-14, 1998 do hereby state that under requirements of P.A. 74, Michigan P.A. of 1970, the corner points mentioned in lines 1 and 2 above were in conformance with regulations and rules therefore as required in the current manual of survey instructions of the United States Department of the Interior, Bureau of Land Management or by a decree of a Court of Law and /or that the corner points mentioned in lines 3, 4 and 5 above were in conformance with the rules of the Michigan Board of Land Surveyors or by a Decree of a Court of Law, established, re-established, monumented, recovered, found as expressed below:

NOTE: Not more than 2 corners, all in the same town and range, may be recorded on this certificate.

	A	B	C	D	E	F	G	H	I	J	K	L	M
1													
2	6		5		4		3		2		1		
3			•										
4	7		8		9		10		11		12		
5													
6	18		17		16		15		14		13		
7													
8	19		20		21		22		23		24		
9													
10	30		29		28		27		26		25		
11													
12	31		32		33		34		35		36		
13													

A. Description of original monument and accessories and/or subsequent restoration:

C-3
GLO Notes
George Cannon (Resurvey)
1855 set wood post
N25°E 61 lks 10" Beech
N65°W 22 lks 8" Beech

June 7, 1972 Delmer Porter #15410
Found boat spike
Set 4 witnesses
Dec. 13, 1988 Clifford Lindergren
#14098 set 1/2" rod and cap #14098
3 witnesses

Nov. 25, 1908
David Bowen Set 4" Square
cedar post in intersection


B. Description of corner evidence found and/or method applied in restoring or reestablishing corner:

C-3
Found 1/2" rod and cap in Mon. Box #14098
found 3 old witnesses



C. Description of monument for corner and accessories established to perpetuate locating the position of the corner:

C-3
1/2" rod and Cap #14098 in Mon. Box.
N44°E 30.56' P.K. nail in curb O.W.
N70°W 27.87' P.K. nail in curb O.W.
N24°W 56.11' P. Pole O.W.
N62°E 33.62' Notch in east end of culvert

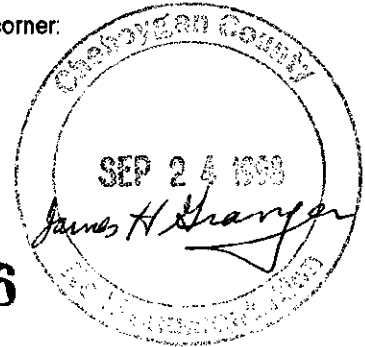

LIBER 011 PAGE 96

Signed by Ronald R. Bischer
Surveyor's Michigan License No. 22428

Date Sept. 28, 1998