

RECEIVED
FOR RECORD

99 DEC 27 PM 4: 03

LAND CORNER RECORDATION CERTIFICATE
Filing Requirement of Act 74, Mich. P.A. 1970

For corners in

<u>Cheboygan</u> (County)	Located In:	Corner Code #
1. Public Land Survey	T34NR 1E	C-4
	T___R___	_____
	T___R___	_____
	T___R___	_____
2. Property Controlling in Section	S___T___R___	_____
	S___T___R___	_____
3. Miscellaneous Property in Sec.	S___T___R___	_____
	S___T___R___	_____

Dicky Pyszynski
CLERK/REGISTER
CHEBOYGAN COUNTY MICHIGAN

RECORDED

MAR 03 2000

SECTION

Register of Deeds Stamp & File Number

4. Lot No. _____, Recorded Plat _____
5. Private Claims _____

	A	B	C	D	E	F	G	H	I	J	K	L
1												
2	6		5		4		3		2		1	
3												
4	7	●	8		9		10		11		12	
5												
6	18		17		16		15		14		13	
7												
8	19		20		21		22		23		24	
9												
10	30		29		28		27		26		25	
11												
12	31		32		33		34		35		36	
13												

I, Ronald Bischer, in a field survey on Aug. 12, 1999 do hereby state that under requirements of P.A. 74, Michigan P.A. of 1970, the corner points mentioned in lines 1 and 2 above were in conformance with regulations and rules therefore as required in the current manual of survey instructions of the United States Department of the Interior, Bureau of Land Management or by a decree of a Court of Law and/or that the corner points mentioned in lines 3, 4 and 5 above were in conformance with the rules of the Michigan Board of Land Surveyors or by a Decree of a Court of Law; established, re-established, monumented, recovered, found as expressed below:

NOTE: Not more than 2 corners, all in the same town and range, may be recorded on this certificate.


A. Description of original monument and accessories and/or subsequent restoration:

C-4
1855 GLO notes Resurvey
S85°W 21 lks 14" Sugar
N65°E 35 lks 7" Sugar

Nov. 25, 1908 David Bowen
3" Sq. cedar post in centerline of N/S road

B. Description of corner evidence found and/or method applied in restoring or reestablishing corner:


C-4
Aug. 12, 1999 Cheboygan County Remonumentation
Ronald Bischer #22428
found 1" Axle shaft replaced with 5/8" rod

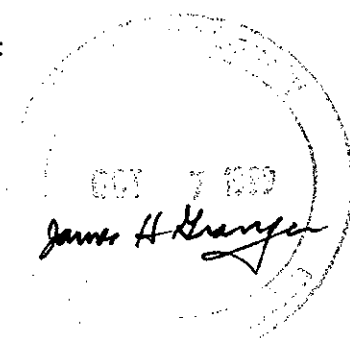

C. Description of monument for corner and accessories established to perpetuate locating the position of the corner:

C-4
5/8" rod and cap #22428
S66°E 35.32' P. Pole
S32°W 90.55' 20" Apple
N82°W 60.64' 18" Lynn
N50°W 19.13' 6" Elm

LIBER 011 PAGE 163

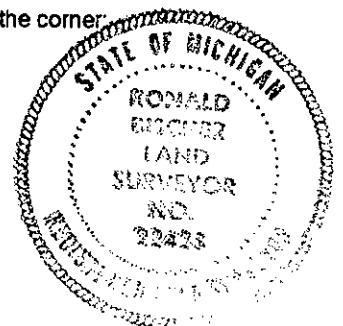

Signed by Ronald R. Bischer
Surveyor's Michigan License No. 22428

Date 12-18-99