

RECEIVED
FOR RECORD

99 DEC 27 PM 4: 06

LAND CORNER RECORDATION CERTIFICATE
Filing Requirement of Act 74, Mich. P.A. 1970

For corners in

<u>Cheboygan</u> (County)	Located In:	Corner Code #
1. Public Land Survey	<u>T 34 N R 1 E</u>	<u>C-5</u>
	T <u> </u> R <u> </u>	<u> </u>
	T <u> </u> R <u> </u>	<u> </u>
	T <u> </u> R <u> </u>	<u> </u>
2. Property Controlling in Section	S <u> </u> T <u> </u> R <u> </u>	<u> </u>
	S <u> </u> T <u> </u> R <u> </u>	<u> </u>
3. Miscellaneous Property in Sec.	S <u> </u> T <u> </u> R <u> </u>	<u> </u>
	S <u> </u> T <u> </u> R <u> </u>	<u> </u>

Christy Pyzyrski
CLERK/REGISTER
CHEBOYGAN COUNTY MICHIGAN

RE

MAR 03 2000

SECTION

Register of Deeds Stamp & File Number

4. Lot No. _____, Recorded Plat _____
5. Private Claims _____

I, Ronald Bischer, in a field survey on Aug. 11, 1999 do hereby state that under requirements of P.A. 74, Michigan P.A. of 1970, the corner points mentioned in lines 1 and 2 above were in conformance with regulations and rules therefore as required in the current manual of survey instructions of the United States Department of the Interior, Bureau of Land Management or by a decree of a Court of Law and/or that the corner points mentioned in lines 3, 4 and 5 above were in conformance with the rules of the Michigan Board of Land Surveyors or by a Decree of a Court of Law; established, re-established, monumented, recovered, found as expressed below:

A	B	C	D	E	F	G	H	I	J	K	L
1											
2	6		5		4		3		2		1
3											
4	7		8		9		10		11		12
5											
6	18		17		16		15		14		13
7											
8	19		20		21		22		23		24
9											
10	30		29		28		27		26		25
11											
12	31		32		33		34		35		36
13											

NOTE: Not more than 2 corners, all in the same town and range, may be recorded on this certificate.

A. Description of original monument and accessories and/or subsequent restoration:

C-5
1855 GLO Notes Resurvey
N15°W 96 lks 15" Beech
N81°E 55 lks 14" Lynn
Nov. 25, 1908 David Bowen
4" Sq. cedar post
N35°W 52' 5" Beech
S55°E 35' 6" Beech

Aug. 1, 1974 Delmer Porter #15410
Set 3/4" pipe from fence corners
East 33.25' fence corner
N54°W 32.47' 12" Maple
West 33.05' Fence corner
S48°W 56.58' 18" Ironwood

B. Description of corner evidence found and/or method applied in restoring or reestablishing corner:


C-5
Aug. 11, 1999 Cheboygan County Remonumentation
Ronald Bischer #22428
found 3/4" pipe replaced with 5/" rod and cap #22428
found all old witnesses



C. Description of monument for corner and accessories established to perpetuate locating the position of the corner:

C-5
5/8" rod and cap #22428
N50°W 32.47' 20" Maple
S83°E 33.50' fence cor.
N80°W 33.05' fence cor.
S52°W 56.58' 18" ironwood

LIBER 011 PAGE 164

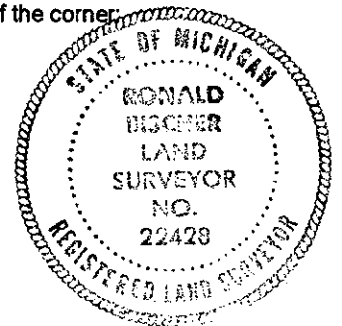

Signed by Ronald P. Bischer
Surveyor's Michigan License No. 22428

Date 12-18-99