

SEP 24 1999

1998 CHEBOYGAN COUNTY, STATE OF MICHIGAN REMONUMENTATION

SECTION

LAND CORNER RECORDATION CERTIFICATE
Filing Requirement of Act 74, Mich. P.A. 1970

For corners in

Cheboygan (County)

Located in:

Corner Code #

Forest Township
1. Public Land Survey

Table with 3 columns: Township/Range, Section, and Corner Code #. Row 1: T 34N R 1E D-3

2. Property Controlling in Section
3. Miscellaneous
Property in Sec.

RECEIVED FOR RECORD 12-7-98
at 9:23 O'Clock A M

Signature of Joanne Spray

CLERK/REGISTER
CHEBOYGAN COUNTY, MICHIGAN

Register of Deeds Stamp & File Number

4. Lot No. , Recorded Plat
5. Private Claims

I, Ronald Bischer, in a field survey on 7-14, 1998 do hereby state that under requirements of P.A. 74, Michigan P.A. of 1970, the corner points mentioned in lines 1 and 2 above were in conformance with regulations and rules therefore as required in the current manual of survey instructions of the United States Department of the Interior, Bureau of Land Management or by a decree of a Court of Law and/or that the corner points mentioned in lines 3, 4 and 5 above were in conformance with the rules of the Michigan Board of Land Surveyors or by a Decree of a Court of Law; established, re-established, monumented, recovered, found as expressed below:

NOTE: Not more than 2 corners, all in the same town and range, may be recorded on this certificate.

Grid table with columns A-M and rows 1-13. A dot is marked at row 3, column D.


A. Description of original monument and accessories and/or subsequent restoration:

D-3
1855 GLO Notes George Cannon (Resurvey)
Set wood post
S60°E 22 lks 14" Beech
N28°W 37 lks 7" Sugar
Nov. 25 1908 David Bowen
4" Square cedar post

June 7, 1972 Delmer Porter #15410
Set P.K. nail by S.P.
3 witnesses
Sept. 13, 1972 Delmer Porter #15410
p.k. nail and 3 witnesses
Dec 13, 1988 Clifford Lindgren #14098
set 1/2" rod and cap #14098 in Mon box
3 witnesses


B. Description of corner evidence found and/or method applied in restoring or reestablishing corner:

D-3
Found 1/2" rod and cap #14098 in mon box
replaced with 5/8" rod and remon cap

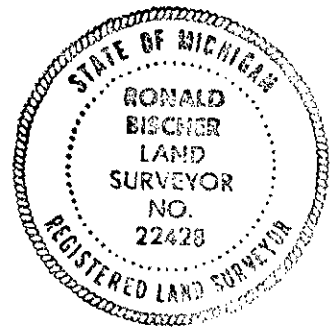

C. Description of monument for corner and accessories established to perpetuate locating the position of the corner:

D-3
5/8" Rod and Remon cap
N08°E 63.80' 1/2" rod O.W.
N19°E 54.37' 5" Maple
S43°W 104.65' Split rail wood fence O.W.
S09°E 89.04' 7" Elm

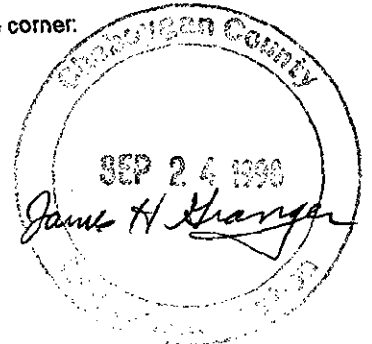

LIBER 011 PAGE 98

Signed by Ronald R. Bischer
Surveyor's Michigan License No. 22428

Date Sept. 28, 1998