

RECEIVED FOR RECORD

99 DEC 27 PM 4: 23

LAND CORNER RECORDATION CERTIFICATE
Filing Requirement of Act 74, Mich. P.A. 1970

For corners in

Deity Agyzinski
CLERK/REGISTER
CHEBOYGAN COUNTY MICHIGAN

<u>Cheboygan</u> (County)	Located In:	Corner Code #
1. Public Land Survey	T <u>34</u> N R <u>1</u> E	<u>D-5</u>
	T <u> </u> R <u> </u>	<u> </u>
	T <u> </u> R <u> </u>	<u> </u>
	T <u> </u> R <u> </u>	<u> </u>
2. Property Controlling in Section	S <u> </u> T <u> </u> R <u> </u>	<u> </u>
	S <u> </u> T <u> </u> R <u> </u>	<u> </u>
3. Miscellaneous Property in Sec.	S <u> </u> T <u> </u> R <u> </u>	<u> </u>
	S <u> </u> T <u> </u> R <u> </u>	<u> </u>

RF

MAR 03 2000

Register of Deeds Stamp & File Number

4. Lot No. _____, Recorded Plat _____
5. Private Claims _____

I, Ronald Bischer, in a field survey on Aug. 1, 1999 do hereby state that under requirements of P.A. 74, Michigan P.A. of 1970, the corner points mentioned in lines 1 and 2 above were in conformance with regulations and rules therefore as required in the current manual of survey instructions of the United States Department of the Interior, Bureau of Land Management or by a decree of a Court of Law and /or that the corner points mentioned in lines 3, 4 and 5 above were in conformance with the rules of the Michigan Board of Land Surveyors or by a Decree of a Court of Law; established, re-established, monumented, recovered, found as expressed below:

	A	B	C	D	E	F	G	H	I	J	K	L	M
1													
2	6		5		4		3		2		1		
3													
4	7		8		9		10		11		12		
5				●									
6	18		17		16		15		14		13		
7													
8	19		20		21		22		23		24		
9													
10	30		29		28		27		26		25		
11													
12	31		32		33		34		35		36		
13													

NOTE: Not more than 2 corners, all in the same town and range, may be recorded on this certificate.

A. Description of original monument and accessories and/or subsequent restoration:


D-5
1855 GLO Notes Resurvey
N75° E 19 lks 11" Beech
S26° W 39 lks 8" Beech

Aug. 1, 1974 Delmer Porter #15410
set 3/4" pipe @ fence corner
S58° W 13.53' 16" Birch
N18° W 21.54' 10" Maple
N50° E 19.77' 8" Maple

Nov. 25, 1908 David Bowen
2x4 cedar post
N9° 30' W 28.50' 10" Beech
S79° 30' W 22' 4" Beech

B. Description of corner evidence found and/or method applied in restoring or reestablishing corner:

D-5
Aug. 11, 1999 Cheboygan County Remonumentation
Ronald Bischer #15410
found 3/4" pipe replaced with 5/8" rod and cap #22428
found all three witnesses

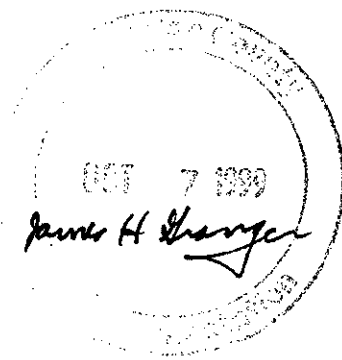

C. Description of monument for corner and accessories established to perpetuate locating the position of the corner:

D-5
3/4" pipe with 5/8" rod inside with cap #22428
S58° W 13.53' 18" Birch
N18° W 21.54' 11" Maple
N50° E 19.77' 12" Maple
South 1.50' 12" fence brace post

LIBER 011 PAGE 178



Signed by Ronald R. Bischer
Surveyor's Michigan License No. 22428

Date 12-18-99