

SEP 24 1998

SEC 1998 CHEBOYGAN COUNTY, STATE OF MICHIGAN REMONUMENTATION

LAND CORNER RECORDATION CERTIFICATE
Filing Requirement of Act 74, Mich. P.A. 1970

For corners in

Cheboygan
(County)

Located In:

Corner Code #

- 1. Public Land Survey T 34N R 1E E-3
 T ___ R ___
 T ___ R ___
 T ___ R ___
- 2. Property Controlling S ___ T ___ R ___
 in Section S ___ T ___ R ___
- 3. Miscellaneous S ___ T ___ R ___
 Property in Sec. S ___ T ___ R ___

RECEIVED FOR RECORD 12-7-98
at 9:36 O'Clock A M

Joanne Spray

CLERK/REGISTER
CHEBOYGAN COUNTY, MICHIGAN
Register of Deeds Stamp & File Number

- 4. Lot No. _____, Recorded Plat _____
- 5. Private Claims _____

I, Ronald Bischer, in a field survey on 7-15, 1998 do hereby state that under requirements of P.A. 74, Michigan P.A. of 1970, the corner points mentioned in lines 1 and 2 above were in conformance with regulations and rules therefore as required in the current manual of survey instructions of the United States Department of the Interior, Bureau of Land Management or by a decree of a Court of Law and /or that the corner points mentioned in lines 3, 4 and 5 above were in conformance with the rules of the Michigan Board of Land Surveyors or by a Decree of a Court of Law, established, re-established, monumented, recovered, found as expressed below:

NOTE: Not more than 2 corners, all in the same town and range, may be recorded on this certificate.

	A	B	C	D	E	F	G	H	I	J	K	L	M
1													
2	6			5		4		3		2		1	
3					●								
4	7			8		9		10		11		12	
5													
6	18			17		16		15		14		13	
7													
8	19			20		21		22		23		24	
9													
10	30			29		28		27		26		25	
11													
12	31			32		33		34		35		36	
13													


A. Description of original monument and accessories and/or subsequent restoration:

E-3
1855 George Cannon (Resurvey)
Set wood post
N65°E 32 lks 24" Sugar
S75°W 27 lks 15' Sugar
Nov. 25, 1908 David Bowen
Set drag tooth

June 7, 1972 Delmer Porter #15410
found 2" axle shaft in mon box
3 witnesses
Sept. 13, 1972 Delmer Porter #15410
2" axle shaft in mon box 3 witnesses
Sept. 23, 1983 Delmer Porter #15410
2" axle shaft in mon box 3 witnesses
Dec 13, 1988 Clifford Lindgren #14098
set 1/2" rod and cap #14098 2 witnesses

B. Description of corner evidence found and/or method applied in restoring or reestablishing corner:


E-3
found 1/2" rod and cap in mon box
replaced with 5/8" rod and remon cap

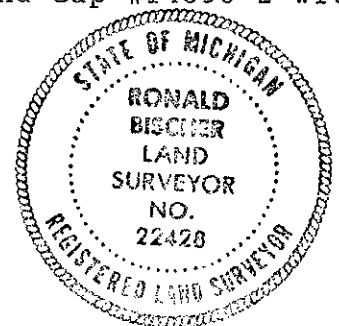

C. Description of monument for corner and accessories established to perpetuate locating the position of the corner:

E-3
5/8" rod and remon cap

N23°E 86.48' Fence post O.W.
N05°W 126.72' P. Pole
N26°W 89.23' Gas Pipe O.W.
S31°E 50.68' Street sign

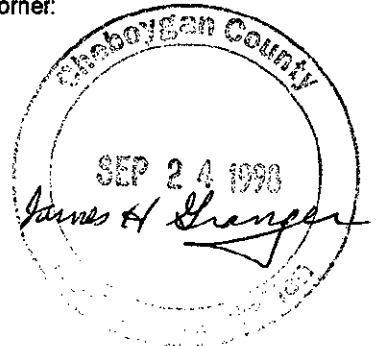

LIBER 011 PAGE 101

Signed by Ronald R. Bischer
Surveyor's Michigan License No. 22428

Date Sept. 28, 1998