

RECEIVED FOR RECORD

99 DEC 27 PM 4: 22

LAND CORNER RECORDATION CERTIFICATE
Filing Requirement of Act 74, Mich. P.A. 1970

Ronald Bischer
CLERK/REGISTER
CHEBOYGAN COUNTY MICHIGAN

For corners in

<u>CHEBOYGAN</u> (County)	Located In:	Corner Code #
1. Public Land Survey	T <u>34N</u> R <u>1E</u>	<u>E-5</u>
	T <u> </u> R <u> </u>	<u> </u>
	T <u> </u> R <u> </u>	<u> </u>
	T <u> </u> R <u> </u>	<u> </u>
2. Property Controlling in Section	S <u> </u> T <u> </u> R <u> </u>	<u> </u>
	S <u> </u> T <u> </u> R <u> </u>	<u> </u>
3. Miscellaneous Property in Sec.	S <u> </u> T <u> </u> R <u> </u>	<u> </u>
	S <u> </u> T <u> </u> R <u> </u>	<u> </u>

MAR 03 2000
Register of Deeds Stamp & File Number
SECTION

4. Lot No. _____, Recorded Plat _____
5. Private Claims _____

I, Ronald Bischer, in a field survey on Aug. 11, 1999 do hereby state that under requirements of P.A. 74, Michigan P.A. of 1970, the corner points mentioned in lines 1 and 2 above were in conformance with regulations and rules therefore as required in the current manual of survey instructions of the United States Department of the Interior, Bureau of Land Management or by a decree of a Court of Law and /or that the corner points mentioned in lines 3, 4 and 5 above were in conformance with the rules of the Michigan Board of Land Surveyors or by a Decree of a Court of Law; established, re-established, monumented, recovered, found as expressed below:

	A	B	C	D	E	F	G	H	I	J	K	L
1												
2	6		5		4		3		2		1	
3												
4	7		8		9		10		11		12	
5					●							
6	18		17		16		15		14		13	
7												
8	19		20		21		22		23		24	
9												
10	30		29		28		27		26		25	
11												
12	31		32		33		34		35		36	
13												

NOTE: Not more than 2 corners, all in the same town and range, may be recorded on this certificate.

A. Description of original monument and accessories and/or subsequent restoration:

E-5	April 23, 1971 Delmer Porter #15410
1855 GLO Notes Resurvey	1 1/2" pipe in road centerline
S57°W 20 lks 17" Hemlock	S49° E 49.5' 8" Maple
N57° E 29 1/2 lks 12" Hemlock	S52° W 48.18' P. Pole
Nov. 25, 1908 David Bowen	Jan 17, 1975 Delmer Porter #15410
4" sq. cedar post in centerline of N/S road	1 1/2" pipe in rd centerline
N57° E 29 1/2 lks 18" old Hemlock stump	N85° W 31.88' fence corner
April 2, 1960 Dean DelaMater #2674	same witnesses as above
1 1/4" pipe S49° E 49.5' 8" Maple; S47° W 48' P. Pole	

B. Description of corner evidence found and/or method applied in restoring or reestablishing corner:


E-5
Aug. 11, 1999 Cheboygan County Remonumentation
Ronald Bischer #22428
fnd. 1 1/4" pipe replaced with 5/8" rod and cap
set 2 new witnesses



C. Description of monument for corner and accessories established to perpetuate locating the position of the corner:

E-5
5/8" rod and cap #22428
S54°W 48.05' P. Pole
S43° E 49.47' 8" Maple
S89° E 47.30' 5" Maple
S15° E 93.36' 8" Maple

LIBER 011 PAGE 177

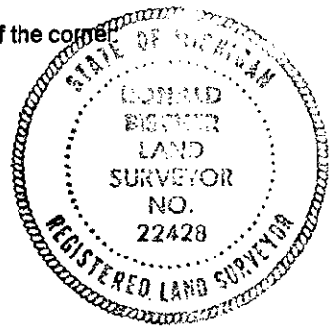

Signed by Ronald E. Bischer
Surveyor's Michigan License No. 22428

Date 12-18-99