

SEP 24 1998

SECTION  
1998 CHEBOYGAN COUNTY, STATE OF MICHIGAN REMONUMENTATION

LAND CORNER RECORDATION CERTIFICATE  
Filing Requirement of Act 74, Mich. P.A. 1970

For corners in

<u>Cheboygan</u> (County)	Located In:	Corner Code #
Forest Township	T 34N R 1E	F-1 ✓
1. Public Land Survey <i>Waverly Township</i>	T 35N R 1E	F-13
	T _____ R _____	_____
	T _____ R _____	_____
2. Property Controlling in Section	S _____ T _____ R _____	_____
	S _____ T _____ R _____	_____
3. Miscellaneous Property in Sec.	S _____ T _____ R _____	_____
	S _____ T _____ R _____	_____

RECEIVED FOR RECORD 12-7-98  
at 9:37 O'Clock A M

*Joanne Gray*

CLERK/REGISTER  
CHEBOYGAN COUNTY, MICHIGAN

Register of Deeds Stamp & File Number

4. Lot No. \_\_\_\_\_, Recorded Plat \_\_\_\_\_  
5. Private Claims \_\_\_\_\_

I, Ronald Bischer in a field survey on 7-15, 1998 do hereby state that under requirements of P.A. 74, Michigan P.A. of 1970, the corner points mentioned in lines 1 and 2 above were in conformance with regulations and rules therefore as required in the current manual of survey instructions of the United States Department of the Interior, Bureau of Land Management or by a decree of a Court of Law and /or that the corner points mentioned in lines 3, 4 and 5 above were in conformance with the rules of the Michigan Board of Land Surveyors or by a Decree of a Court of Law, established, re-established, monumented, recovered, found as expressed below:


NOTE: Not more than 2 corners, all in the same town and range, may be recorded on this certificate.

	A	B	C	D	E	F	G	H	I	J	K	L	M
1													
2	6		5		4		3		2		1		
3													
4	7		8		9		10		11		12		
5													
6	18		17		16		15		14		13		
7													
8	19		20		21		22		23		24		
9													
10	30		29		28		27		26		25		
11													
12	31		32		33		34		35		36		
13													

A. Description of original monument and accessories and/or subsequent restoration:

F-1  
1840 John Hodgson  
1855 George Cannon (Resurvey)  
Set wood post  
N42°E 28 lks 15" Y. Pine  
N47°W 90 lks 15" Y. pine  
Nov. 6, 1964 Orlando Doyle #7319  
Found stake replaced with 3/4" Pipe  
3 witnesses

June 12, 1978 Ronald Bischer #22428  
found 3/4" Pipe and 4x4 stake  
3 witnesses

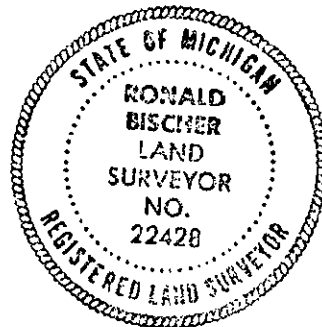


B. Description of corner evidence found and/or method applied in restoring or reestablishing corner:

F-1  
found 3/4" pipe and 2 witnesses  
replaced with 5/8" rod and remon cap

C. Description of monument for corner and accessories established to perpetuate locating the position of the corner:

F-1  
5/8" rod and remon cap  
N20°W 48.85' 10" Norway O.W.  
S70°W 59.20' 18" Norway O.W.  
S33°E 31.73' 9" Norway  
N66°E 15.17' 8" Norway

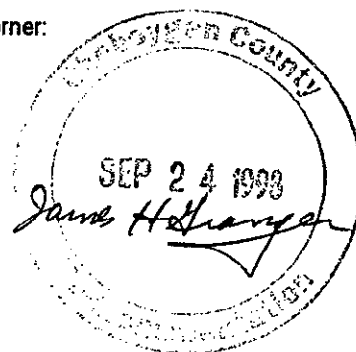

LIBER 011 PAGE 102

Signed by Ronald R. Bischer  
Surveyor's Michigan License No. 22428

Date Sept. 28, 1998