

1998 CHEBOYGAN COUNTY, STATE OF MICHIGAN REMONUMENTATION

SECTION 2
 RECONSTRUCTION
 1998

LAND CORNER RECORDATION CERTIFICATE
 Filing Requirement of Act 74, Mich. P.A. 1970

For corners in

Cheboygan Located In: Corner Code #
 (County)
 Forest Township
 1. Public Land Survey T 34N R 1E G-1
Waverly Township T 35N R 1E G-13
 T R
 T R
 2. Property Controlling S T R
 in Section S T R
 3. Miscellaneous S T R
 Property in Sec. S T R

SECTION
 RECEIVED FOR RECORD 12-7-98
 at 9:39 O'Clock A M

Josanne Gray

CLERK/REGISTER
 CHEBOYGAN COUNTY, MICHIGAN

Register of Deeds Stamp & File Number

4. Lot No. _____, Recorded Plat _____
 5. Private Claims _____

I, Ronald Bischer, in a field survey on 7-17, 1998 do hereby state that under requirements of P.A. 74, Michigan P.A. of 1970, the corner points mentioned in lines 1 and 2 above were in conformance with regulations and rules therefore as required in the current manual of survey instructions of the United States Department of the Interior, Bureau of Land Management or by a decree of a Court of Law and/or that the corner points mentioned in lines 3, 4 and 5 above were in conformance with the rules of the Michigan Board of Land Surveyors or by a Decree of a Court of Law; established, re-established, monumented, recovered, found as expressed below:

A	B	C	D	E	F	G	H	I	J	K	L	M
1												
2	6	5	4	3	2	1						
3												
4	7	8	9	10	11	12						
5												
6	18	17	16	15	14	13						
7												
8	19	20	21	22	23	24						
9												
10	30	29	28	27	26	25						
11												
12	31	32	33	34	35	36						
13												

NOTE: Not more than 2 corners, all in the same town and range, may be recorded on this certificate.

A. Description of original monument and accessories and/or subsequent restoration:

G-1
 1840 John Hodgson
 1855 George Cannon (Resurvey)
 set wood post and 4 witnesses
 March 22, 1975 Delmer Porter #15410
 Found 1" pipe in pond
 set 2 witnesses

Sept 12, 1977 Delmer Porter #15410
 found 1" Pipe in pond
 2 witnesses


B. Description of corner evidence found and/or method applied in restoring or reestablishing corner:

G-1
 Found 1" pipe in pond
 set 5/8" rod and remon cap inside 1" pipe



C. Description of monument for corner and accessories established to perpetuate locating the position of the corner:

G-1
 5/8" rod and remon cap
 S59°W 11.25' 9" Norway O.W.
 N87°W 22.20' 10" Norway O.W.
 S50°W 19.70' 20" Oak
 S04°E 25.55' 6" J. Pine
 6' to the shore

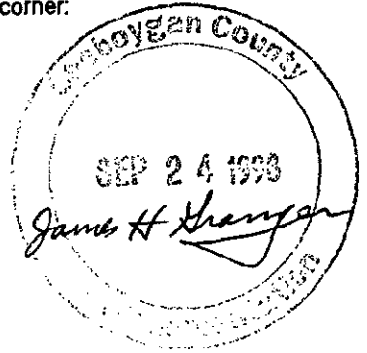

LIBER 011 PAGE 104

Signed by Ronald R. Bischer
 Surveyor's Michigan License No. 22428

Date Sept. 28, 1998