

MAR 22 1999

LAND CORNER RECORDATION CERTIFICATE
Filing Requirement of Act 74, Mich. P.A. 1970

SECTION

For corners in

<u>Cheboygan</u> (County)	Located In:	Corner Code #
Forest Township		
1. Public Land Survey	T <u>34</u> N R <u>1 E</u>	<u>G-2</u>
	T <u> </u> R <u> </u>	<u> </u>
	T <u> </u> R <u> </u>	<u> </u>
	T <u> </u> R <u> </u>	<u> </u>
2. Property Controlling in Section	S <u> </u> T <u> </u> R <u> </u>	<u> </u>
	S <u> </u> T <u> </u> R <u> </u>	<u> </u>
3. Miscellaneous Property in Sec.	S <u> </u> T <u> </u> R <u> </u>	<u> </u>
	S <u> </u> T <u> </u> R <u> </u>	<u> </u>

RECEIVED FOR RECORD 12-7-98
at 9:40 O'Clock 4 M

Joanne Gray

CLERK/REGISTER
CHEBOYGAN COUNTY, MICHIGAN

Register of Deeds Stamp & File Number

4. Lot No. _____, Recorded Plat _____
5. Private Claims _____

I, Ronald Bischer, in a field survey on 7-20, 19 98 do hereby state that under requirements of P.A. 74, Michigan P.A. of 1970, the corner points mentioned in lines 1 and 2 above were in conformance with regulations and rules therefore as required in the current manual of survey instructions of the United States Department of the Interior, Bureau of Land Management or by a decree of a Court of Law and /or that the corner points mentioned in lines 3, 4 and 5 above were in conformance with the rules of the Michigan Board of Land Surveyors or by a Decree of a Court of Law; established, re-established, monumented, recovered, found as expressed below.

NOTE: Not more than 2 corners, all in the same town and range, may be recorded on this certificate.

A	B	C	D	E	F	G	H	I	J	K	L	M
1												
2	6		5		4	●	3		2		1	
3												
4	7		8		9		10		11		12	
5												
6	18		17		16		15		14		13	
7												
8	19		20		21		22		23		24	
9												
10	30		29		28		27		26		25	
11												
12	31		32		33		34		35		36	
13												

A. Description of original monument and accessories and/or subsequent restoration:


G-2
1855 George Cannon (Resurvey)
Set wood post and 2 witnesses

Sept. 12, 1977 Delmer Porter #15410
found 1" pipe and 3 witnesses
Sept. 23, 1983 Delmer Porter #15410
1" pipe and 3 witnesses

Aug 1952 Orlando Doyle #7319
1" pipe and 3 witnesses
March 22, 1975 Delmer Porter #15410
found 1" pipe and 2 witnesses


B. Description of corner evidence found and/or method applied in restoring or reestablishing corner:

G-2
Found 1" pipe
Placed 5/8" rod and remon cap inside 1" pipe

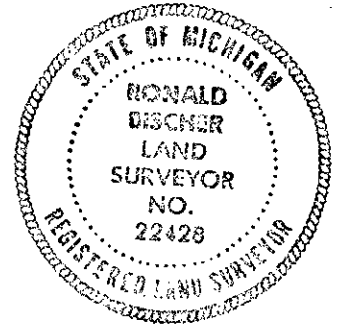

C. Description of monument for corner and accessories established to perpetuate locating the position of the corner:

G-2
5/8" rod and remon cap
N88°W 24.72' 7" Twin J. Pine O.W.
N18°W 20.80' 9" J. Pine
S20°E 23.56' 10" Maple
S11°W 34.36' Fence Corner

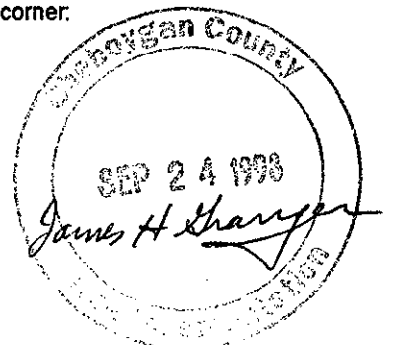

LIBER 011 PAGE 105

Signed by Ronald R. Bischer
Surveyor's Michigan License No. 22428

Date Sept. 28, 1998